


Butler
 Map No. KANSAS Sec. 6 Twp. 25^S R. 4^E
 Well No. 2-Houston Farm
Crawford et al Company

NORTH

WEST

EAST

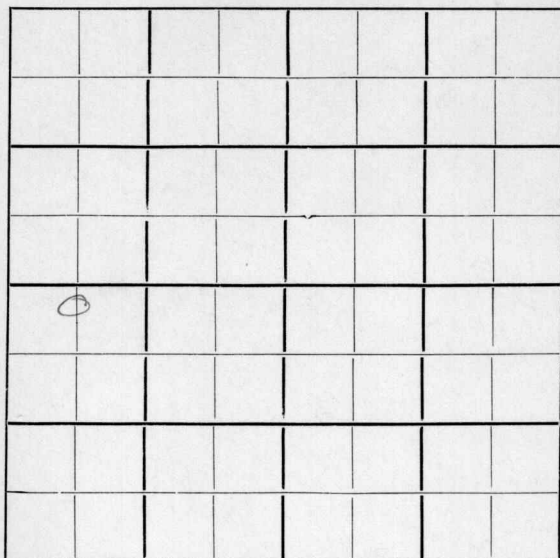

SOUTH

Location.....

Drilling Remarks

.....

.....

.....

.....

.....

.....

.....

.....

.....

.....

RECORD

Cased.....in.....ft.

Sand.....

Gas.....

Oil.....

Total Depth.....

Rig Up.....

Drilling Remarks

.....

.....

.....

.....

.....

.....

.....

.....

.....

.....

PRODUCTION

1st 24 hrs. Nat.....

1st 24 hrs. after shot.....

Gas.....cu. ft.....

Dry Hole.....

Abandoned.....

Map No. Sec. Twp. R.

Well No. Farm


..... Company

..... Ft. from N. Line

..... Ft. from S. Line

..... Ft. from E. Line

..... Ft. from W. Line

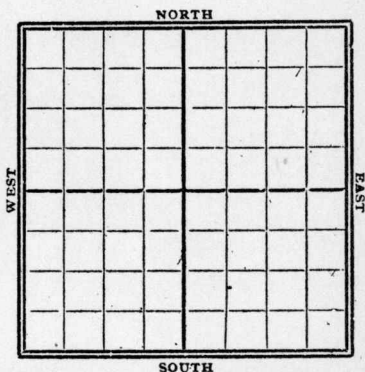

1928

Date

REPORT

Gypsy Records

~~3/28~~ 3/28 Abd T.D. 2700'

K14

MAP NO. KANSAS SEC. 6 TWP. 25S R. 4E

WELL NO. 2 Kenston

Crawford et al COMPANY

CONTRACTOR

SECTION PLAT

ABANDONED

_____ FT. FROM N. LINE

_____ FT. FROM S. LINE

_____ FT. FROM E. LINE

_____ FT. FROM W. LINE

●			

RECORD

LOCATION _____

CASED _____ IN. _____ FT.

RIG UP _____

SAND _____

DRILLING AND REMARKS:

GAS _____

OIL _____

TOTAL DEPTH 2700

PRODUCTION

1ST 24 HRS. NAT. _____

1ST 24 HRS. AFTER SHOT _____

GAS _____ CU. FT.

DRY HOLE ☒

ABANDONED ☒

DATE

3/28 192 1 SCOUT