


Section 6 Township 25 Range 4 E

Well No. # 4 Houston

Company Cox & Burns

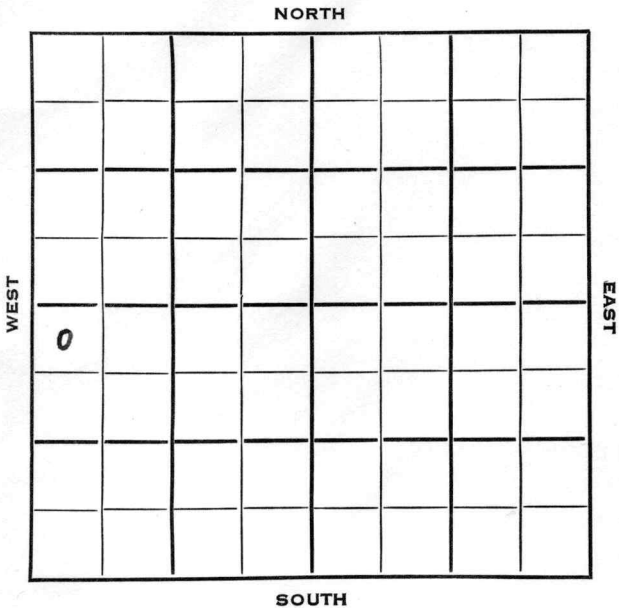

SEC.	Butler		R.	KANSAS
6	TWP.	25	4E	✓


WELL NO.	#4 Houston	FARM
COMPANY	Cox & Burns	
CONTRACTOR	Cox & Burns	

330 _____ Ft. from N. Line

_____ Ft. from S. Line

_____ Ft. from E. Line

330 _____ Ft. from W. Line

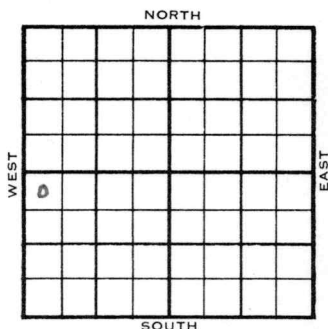

NW NW SW

1953	ELEVATION	REPORT
	1299'	

9/9
10/21

Location
Spud 9-11-53
Oil Well
TD 2677'
15" @ 40'
12" @ 900'
10" @ 1175'
8" @ 1688'
Lans 1935, KC 2210,
7" @ 2323'
Miss 2665
5" @ 2670'
TD 2677'
1000 A
Comp 15 bopd.

COMPLETED

County Butler State Kansas

Sec. 6 (Blk. Twp.) 25 (Sur. Rge.) 4E Map No.

Operator Cox & Burns

Well No. 4 Farm Houston

Elev.	Location	NW	NW	SW
-------	----------	----	----	----

330 Ft. From N Line SW

330 Ft. From W Line Quarter

1st. Report SEP 9 1953

Completion

Remarks

Cox & Burns - Contr.

Spudding Date _____

Drlg. Data

Location

J. G. McGEHEE

Kadavil

(Blk.)
(Twp.)

(Sur.)
(Rge.)

Cox & Burns

Farm Houston

1299	Location	NW NW SW
------	----------	----------

330 Ft. From N Line SW

330 Ft. From ^W Line Quarter

Completion OCT 21 1959

Cox & Burns - Contr.

Spudding Date 9-11-53

Oil well TD 2677

15" @ 40 12" @ 900 10" @ 1175

8" @ 1688 Lans. 1935 KC 2210

7" @ 2323 Miss. 2665 5" @ 2670

TD 2677 1000 A Comp. 15 bopd

J. G. McGEHEE