

KANSAS

Map No. Sec. 4 Twp. 27 R. 13

Well No. 1 - Lawrence Farm

Ladlow Gas Company


.....Ft. from N. Line

200 Ft. from S. Line

.....Ft. from E. Line

1120 Ft. from W. Line

1928

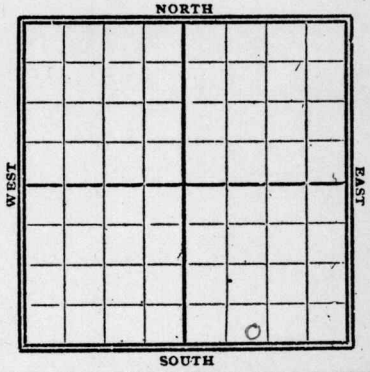

Date

REPORT

7/25	Drily 730'
8/2	" 950
8/9	S.D. 950
8/16	—
8/23	Drily 1000'
8/28	—
9/4	S.D. —
9/12	Drily. 1625
9/19	—
9/26	S.D. - 1625'
10/3	Top line 1625 show oil 1305-20 T.D. 1630'
	Dry & Abandoned

Sherwood

no tracking
KANSAS

MAP NO. _____ SEC. 4 TWP. 27 R. 13

WELL NO. _____

Lawrence
Robert *Sos* *Co*

COMPANY

CONTRACTOR

FIRST REPORTS

SECTION PLAT

_____ FT. FROM N. LINE

200 FT. FROM S. LINE

_____ FT. FROM E. LINE

1120 FT. FROM W. LINE

LOCATION _____

RIG UP _____

DRILLING AND REMARKS:

Log 730'

RECORD

CASED _____ IN. _____ FT.

SAND _____

GAS _____

OIL _____

TOTAL DEPTH _____

PRODUCTION

1ST 24 HRS. NAT. _____

1ST 24 HRS. AFTER SHOT _____

GAS _____ CU. FT.

DRY HOLE _____

ABANDONED _____

DATE

JUL 25 1928

CHAS. L. SHERWOOD

192

SCOUT

Sherwood

MAP NO. KANSAS SEC. 4 TWP. 27 R. 13

WELL No. 1 Lawrence
Hadaw Gas Co COMPANY

CONTRACTOR

SECTION PLAT

COMPLETED

200 FT. FROM N. LINE
1120 FT. FROM S. LINE
FT. FROM E. LINE
1120 FT. FROM W. LINE

ABANDONED

LOCATION _____

RIG UP _____

DRILLING AND REMARKS:

Top limy 1675'
Show oil 1305-20'
Dga 1630

RECORD

CASED _____ IN. _____ FT.
SAND _____
GAS _____
OIL _____
TOTAL DEPTH 1630'

PRODUCTION

1ST 24 HRS. NAT. _____
1ST 24 HRS. AFTER SHOT _____
GAS _____ CU. FT.
DRY HOLE
ABANDONED

DATE

OCT 3 1928

CHAS. L. SHERWOOD
SCOUT