


Map No. Kane Sec. 13 Twp. 23 R. 13

Well No. 1 Bahr Farm
Tidal Oil Company

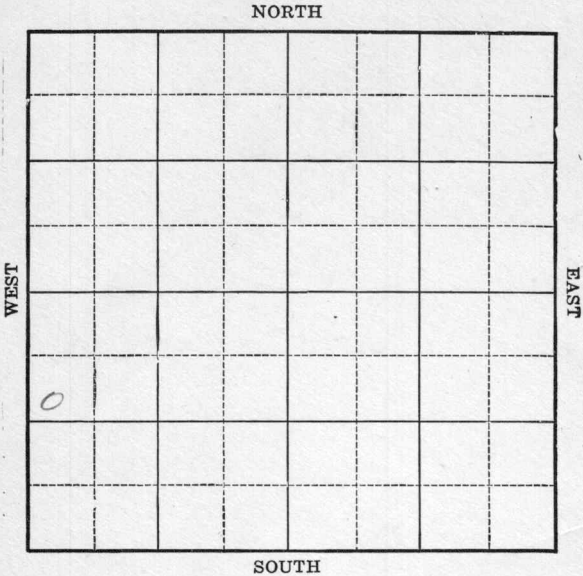

Location _____
Drilling Remarks _____

Rig Up _____
Drilling Remarks _____

RECORD

Cased _____ in. _____ ft.
Sand _____
Gas _____
Oil _____
Total Depth _____

PRODUCTION

1st 24 hrs. Nat. _____
1st. 24 hrs. after shot _____
Gas _____ cu. ft.
Dry Hole _____
Abandoned _____

Coffee

Map No. *Kansel* Sec. *13* Twp. *23* R. *13*

Well No. *1* *Bahr* Farm


Tidal Oil Company

1120 Ft. from N. Line

_____ Ft. from S. Line

_____ Ft. from E. Line

200 Ft. from W. Line

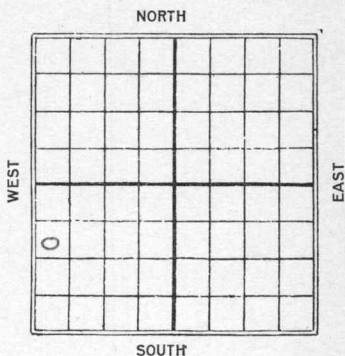

Date
1925

REPORT

1/21 Spud
3/1 D. & G. 1850

Map No. 17 **KANSAS** Sec. 13 Twp. 23 R. 13

Well No. 1- Baker

Tidal oil Company

Contractor

FIRST REPORT

SECTION PLAT

1120 Ft. from N. Line

_____ Ft. from S. Line

_____ Ft. from E. Line

200 Ft. from W. Line

Location _____

Rig up _____

Drilling and Remarks:

spud

RECORD

Cased _____ in., _____ ft.

Sand _____

Gas _____

Oil _____

Total Depth _____

PRODUCTION

1st 24 hrs. Nat. _____

1st 24 hrs. after shot _____

Gas _____ Cu. Ft.

Dry Hole _____

Abandoned _____

Date

1/21 1925

M. A. BENEAR

Scout

Map No. **KANSAS** Sec. 13 Twp. 23 R. 13

Well No. 1 Bahr

Tidal oil Company

Contractor

SECTION PLAT

ABANDONED

1120 Ft. from N. Line

_____ Ft. from S. Line

_____ Ft. from E. Line

200 Ft. from W. Line

0			

Location _____

Rig up _____

Drilling and Remarks:

L & G
1850'

RECORD

Cased _____ in., _____ ft.

Sand _____

Gas _____

Oil _____

Total Depth _____

PRODUCTION

1st 24 hrs. Nat. _____

1st 24 hrs. after shot _____

Gas _____ Cu. Ft.

Dry Hole _____

Abandoned _____

Date

3/1 1925

M. A. BENTAR

Scout