


Map No. KANSAS Sec. 12 Twp. 23 R. 14E
Well No. 4-Canoch Farm
Johnson Company

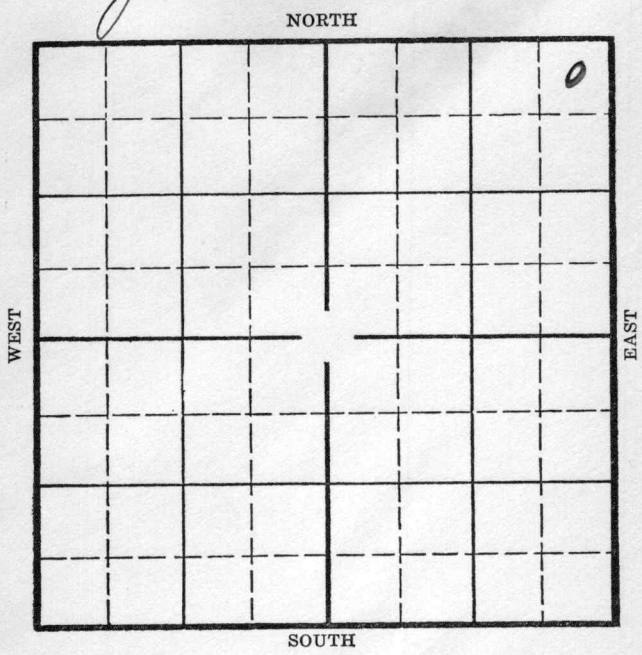

Location _____
Drilling Remarks _____

Rig Up _____
Drilling Remarks _____

RECORD

Cased _____ in. _____ ft.
Sand _____
Gas _____
Oil _____
Total Depth _____

PRODUCTION

1st 24 hrs. Nat. _____
1st 24 hrs. after shot _____
Gas _____ cu. ft. _____
Dry Hole _____
Abandoned _____

KANSAS

Coffey 23 14E


Map No. _____ Sec. 12 Twp. 23 R. 14E
Well No. 4- Vanocher Johnson et al Farm _____
Company _____

330 Ft. from N. Line

_____ Ft. from S. Line

330 Ft. from E. Line

_____ Ft. from W. Line

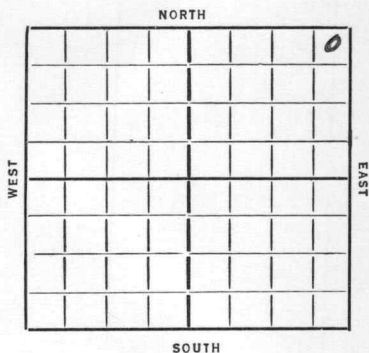

REPORT

~~1956~~
1/8 slg 650
1/17 " 1050
1/24 sp 1149-58 50
line 1516 6" 1517
TD 1563 so will acidize
1/31 No report
2/7 ~~2000 acid~~
2/14 No acid given (Corr)
TD 1563 200' OI H 3 days
Wtu Broke in SP.
2/21 —
2/28 CO
3/4 TL 1516
TD 1563

D & A.

ABANDONED

KANSAS

Map No. 17 Sec. 12 Twp. 23 R. 14E

Well No. 4 - Vanocker

Johnson et al Company

Contractor

SECTION PLAT

330 Ft. from N. Line

..... Ft. from S. Line

330 Ft. from E. Line

..... Ft. from W. Line

			0

FIRST REPORT

Location.....

Rig up.....

Drilling and Remarks:

dry 650

RECORD

Cased.....in.,ft.

Sand.....

Gas.....

Oil.....

Total Depth.....

PRODUCTION

1st 24 hrs. Nat.....

1st 24 hrs. after shot.....

Gas.....Cu. Ft.

Dry Hole.....

Abandoned.....

Date

JAN 8 1936 192.....

ORVAL MANNSCHRECK

Scout

KANSAS

Map No. 17 Sec. 12 Twp. 23 R. 14EWell No. 4 - VanockerJohnson et al Company

Contractor

ABANDONED

SECTION PLAT

330 Ft. from N. Line

Ft. from S. Line

330 Ft. from E. Line

Ft. from W. Line

			0

Location

Rig up

Drilling and Remarks:

10 # 17

RECORD

Cased 1516 in., 1563 ft.Sand TL

Gas

Oil

Total Depth 1563

PRODUCTION

1st 24 hrs. Nat.

1st 24 hrs. after shot

Gas Cu. Ft.

Dry Hole

Abandoned

Date

3-4-36 192 Scout

ORVAL MANNSCHRECK