

NORTH

WEST

EAST

SOUTH

Drilling Remarks

Drilling Remarks

RECORD

Cased _____ in. _____ ft.

Sand_____

Gas _____

Oil_____

Total Depth_____

PRODUCTION

1st 24 hrs. Nat.

1st 24 hrs. after shot_____

Gas _____ cu. ft. _____

Dry Hole.....

Abandoned_____

Coffey


Map No. KANSAS Sec. 12 Twp. 23 R. 14E
Well No. 3- Vannocker Farm
Hinge et al Company

760 Ft. from N. Line

_____ Ft. from S. Line

_____ Ft. from E. Line

1120 Ft. from W. Line

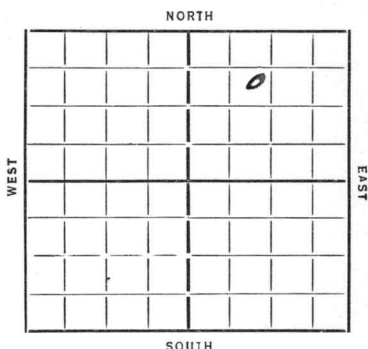

Date 1935

REPORT

4/17 Log 1400

4/26 6" 1400

5/2 5/9

5/16 TL 1503 200' 1528-39

T7 1550 1000 acid

5/23

5/28 Line 1503 T7 1550

1000 acid 15 bbls.

COMPLETED

Map No. K17 Sec. 12 Twp. 23 R. 14 EWell No. 3-VannockHinger et al Company

Contractor

SECTION PLAT

COMPLETED

760 Ft. from N. Line

Ft. from S. Line

Ft. from E. Line

1120 Ft. from W. Line

		0	

Location

Rig up

Drilling and Remarks:

1000 and15 fph

RECORD

Cased _____ in., _____ ft.

Sand Time 1503

Gas _____

Oil _____

Total Depth 1550

PRODUCTION

1st 24 hrs. Nat. _____

1st 24 hrs. after shot _____

Gas _____ Cu. Ft.

Dry Hole _____

Abandoned _____

Date

5-28-35

192

ORVAL MANNSCHRECK

Scout

Map No. 17 Sec. 12 Twp. 23 R. 14 EWell No. 3-VannockerHinge et al Company


Contractor

SECTION PLAT

760 Ft. from N. Line

Ft. from S. Line

Ft. from E. Line

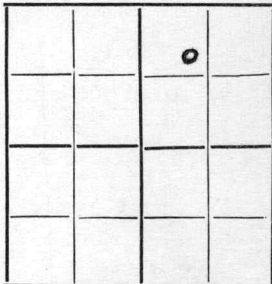1120 Ft. from W. Line

Location

Rig up

Drilling and Remarks:

psg 1400

RECORD

Cased.....in.,ft.

Sand.....

Gas.....

Oil.....

Total Depth.....

PRODUCTION

1st 24 hrs. Nat.....

1st 24 hrs. after shot.....

Gas.....Cu. Ft.

Dry Hole.....

Abandoned.....

Date

ORVAL MANNSCHRECK

4-17-35 192.....Scout