
Form 51 5M 2-22 8411

Map No. _____ Sec. 14 Twp. 23 R. 13

Well No. 5 Elliott Farm

Mendenhall & Winkler Company

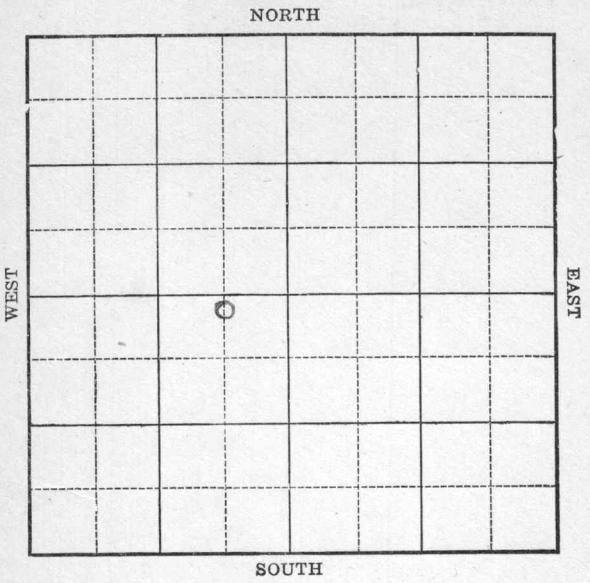

Location _____

Drilling Remarks:

Rig Up _____

Drilling Remarks:

RECORD

Cased _____ in. _____ ft.

Sand _____

Gas _____

Oil _____

Total Depth _____

PRODUCTION

1st 24 hrs. Nat. _____

1st 24 hrs. after shot _____

Gas _____ cu. ft.

Dry Hole _____

Abandoned _____

Form 252A 5M 8-21 PALACE-TULSA 6835

Map No. _____ Sec. 14 Twp. 23 R. 13

Well No. 5 Elliott Farm


Mendenhall & Winkler Company

200 Ft. from N, Line

_____ Ft. from S. Line

660 Ft. from E. Line

_____ Ft. from W. Line

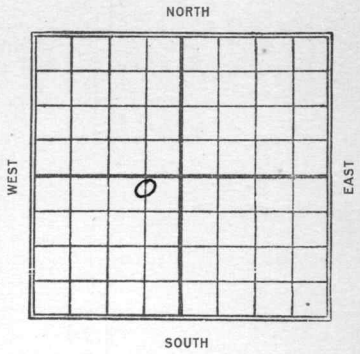

Date 1923	REPORT
1/26	Topline 1784'
3/2	Sand 1816-46 - Shot 40 qts. 4 Bbls.

Form 26—1M—4-19—Mid-West

Map No. KANSAS Sec. 14 Twp. 23 R. 13


Well No. 3 C Elliott

Mendenhall & Winkler Company

_____ Contractor

FIRST REPORT

SECTION PLAT

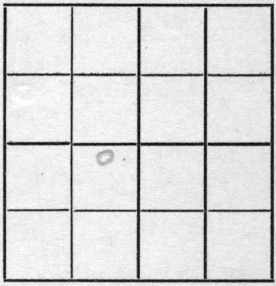

200 Ft. from N. Line

_____ Ft. from S. Line

660 Ft. from E. Line

_____ Ft. from W. Line

Location _____

Rig up _____

Drilling and Remarks:

Top Lime 1784

RECORD

Cased _____ in., _____ ft.

Sand _____

Gas _____

Oil _____

Total Depth _____

PRODUCTION

1st 24 hrs. Nat. _____

1st 24 hrs. after shot _____

Gas _____ Cu. Ft.

Dry Hole _____

Abandoned _____

Date JAN 26 1923

_____ 191_____

M. A. BENEAR Scout

Form 26—1M—4-19—Mid-West

Map No. KANSAS 17 Sec. 14 Twp. 23 R. 13


Well No. 5 E Shiatt

Mundan Galt & Winter Company

Contractor

COMPLETED

SECTION PLAT

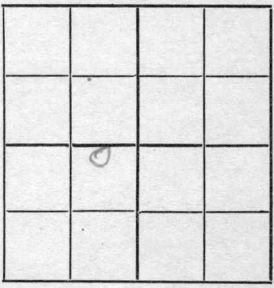

2a Ft. from N. Line

Ft. from S. Line

660 Ft. from E. Line

Ft. from W. Line

Location

Rig up

Drilling and Remarks:

Lay L. 1784

D. 1816-46

4087/+166

RECORD

Cased in., ft.

Sand

Gas

Oil

Total Depth

PRODUCTION

1st 24 hrs. Nat.

1st 24 hrs. after shot

Gas Cu. Ft.

Dry Hole

Abandoned

Date

MAR 2 1923

191

M. A. BENEAR

Scout