


Sedgwick
 Map No. **KANSAS** Sec. *20* Twp. *28* R. *1E*
 Well No. *Geo. Holman* Farm
Geo. Hickney Company

NORTH

WEST

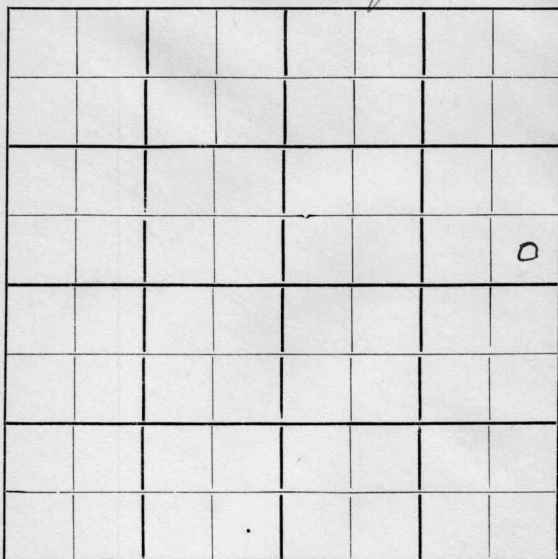

EAST

SOUTH

Location.....

Rig Up.....

Drilling Remarks

Drilling Remarks

.....

.....

RECORD

PRODUCTION

Cased..... in..... ft.

1st 24 hrs. Nat.....

Sand.....

1st 24 hrs. after shot.....

Gas.....

Gas..... cu. ft.....

Oil.....


Dry Hole.....

Total Depth.....

Abandoned.....

Map No. KANSAS Sec. 20 Twp. 28 R. 1E
Well No. 1- Nolan Farm
Geo. Wickey Company

_____ Ft. from N. Line
250 Ft. from S. Line
290 Ft. from E. Line
_____ Ft. from W. Line

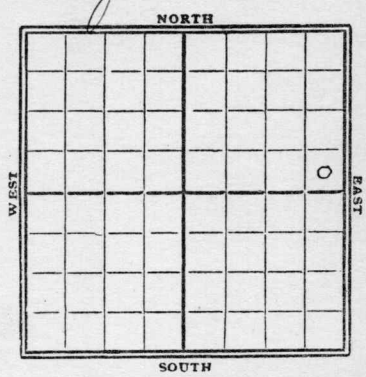

1929

Date	REPORT
5/1	Co. I
5/1	—
5/8	Rigging up
5/15	—
5/22	Spud 2535'
5/29	Reel 900'
6/5	" 1560
6/12	" 2025'
6/19	" 2475'
6/26	" 2750'
7/2	" 3050'
7/10	Chat 3084-95'
	244 gas
	252 bbls oil
	1% water
	T.D. 3100'
	Pump

Map No. KANSAS Sec. 20 Twp. 28 R. 1E
 Well No. 1 Nolan

Geo Dickey Company
 Contractor

SECTION PLAT

..... Ft. from N. Line
250 Ft. from S. Line
290 Ft. from E. Line
 Ft. from W. Line

			0

FIRST REPORTS

Location.....
 Rig up.....
 Drilling and Remarks:

ROG

RECORD

Cased..... in., ft.
 Sand.....
 Gas.....
 Oil.....
 Total Depth.....

PRODUCTION

1st 24 hrs. Nat.....
 1st 24 hrs. after shot.....
 Gas..... Cu. Ft.
 Dry Hole.....
 Abandoned.....

Date

MAY 1 1929
 192.....

S. J. LEWIS Scout

Map No. KANSAS Sec. 20 Twp. 28 R. 1E

Well No. 1 Nolan

Geo. Hickery Company

Contractor

SECTION PLAT

_____ Ft. from N. Line

250 Ft. from S. Line

290 Ft. from E. Line

_____ Ft. from W. Line

COMPLETED

Location _____

Rig up _____

Drilling and Remarks:

Chat 3084-95

2M Gas.

252 88k oil

1% water

RECORD

Cased _____ in., _____ ft.

Sand _____

Gas _____

Oil _____

Total Depth 8100.

PRODUCTION

1st 24 hrs. Nat. _____

1st 24 hrs. after shot _____

Gas _____ Cu. Ft.

Dry Hole _____

Abandoned _____

Date

JUL 10 1929

19

S. J. LEWIS

Scout