


Map No. 75 Sec. 1 Twp. 23 R. 10Well No. 1- Bell Farm
Gruber, Lauer & Co Company200 Ft. from N. Line

Ft. from S. Line

1120 Ft. from E. Line

Ft. from W. Line

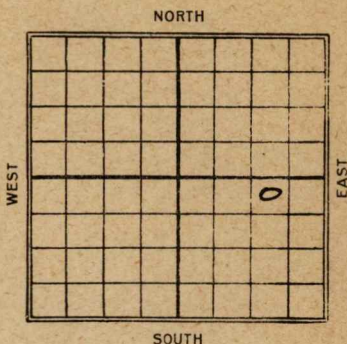

REPORT

Date

1924
5/22 Rig up
7/16 Top L. 2170'
fishing @ 2320
10/28 LQ & A - 2340'
11/12 Top Line 2170
D & A. 2340'

Map No. **KANSAS** Sec. 1 Twp. 23 R. 10

Well No. #1 Bull
Fisher Land Co. Company

Contractor

FIRST REPORT

SECTION PLAT

200 Ft. from N. Line
 _____ Ft. from S. Line
1120 Ft. from E. Line
 _____ Ft. from W. Line

			0

Location _____

Rig up ✓✓ _____

Drilling and Remarks:

RECORD

Cased _____ in., _____ ft.
 Sand _____
 Gas _____
 Oil _____
 Total Depth _____

PRODUCTION

1st 24 hrs. Nat. _____
 1st 24 hrs. after shot _____
 Gas _____ Cu. Ft.
 Dry Hole _____
 Abandoned _____

Date

MAY 22 1924

M. A. BENEAR

192

Scout

(16) **KANSAS** Map No. _____ Sec. 1 Twp. 23 R. 10

Well No. 1 Bell
Fisher Lusk & Moore Company

Contractor _____

ABANDONED

SECTION PLAT

200 Ft. from N. Line

_____ Ft. from S. Line

1120 Ft. from E. Line

_____ Ft. from W. Line

			0

Location _____

Rig up _____

Drilling and Remarks:

Tap L. 2170

1049
2340

RECORD

Cased _____ in., _____ ft.

Sand _____

Gas _____

Oil _____

Total Depth _____

PRODUCTION

1st 24 hrs. Nat. _____

1st 24 hrs. after shot _____

Gas _____ Cu. Ft.

Dry Hole _____

Abandoned _____

Date
 NOV 12 1924

M. A. BENEAR

192

Scout