


Section 12 Township 23 Range 14-E

Well No. #2 Stuckey

Company Huey et al


NORTH Miscellaneous

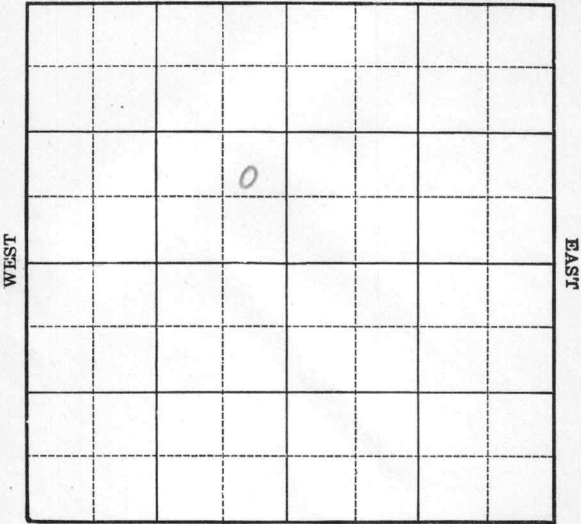

SOUTH

Sec. 12 Twp. 23 R. 14EWell No. #2 Stuckey FarmHuey et al Company

## Miscellaneous

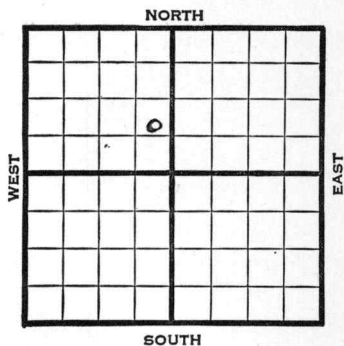       Ft. from N. Line880 Ft. from S. Line330 Ft. from E. Line       Ft. from W. Line

1940

## REPORT

10/26 Machine

10/31 "

11/7 "

11/14 Drlg. 450'

11/21 10" - 956' 8" - 1375'

Drlg. 1470'

11/27 Miss. 1556' Pay 1586-89'

6" - 1584' T.D. 1594' water.

P.B. 1592'

12/5 Shut down.

12/11 Miss. 1556'

6" - 1584'

T.D. 1594'

P.B. to 1592'

1000 acid.

Pump 50 oil &amp; 100 water.

35. Gravity

COMPLETED

Map No. 17 Sec. 12 Twp. 23 R. 14EWell No. 2 StuckeyHuey etal

Company

FIRST REPORT  
CORRECTION

Contractor

## FIRST REPORT

SE NE SE NW

## SECTION PLAT

|  |  |  |  |
|--|--|--|--|
|  |  |  |  |
|  |  |  |  |
|  |  |  |  |
|  |  |  |  |
|  |  |  |  |

       Ft. from N. Line880 Ft. from S. Line330 Ft. from E. Line       Ft. from W. Line

## MISCELLANEOUS

Location                                 Rig up                                 

Drilling and Remarks:

Machine

## RECORD

Cased            in.,            ft.Sand                                 Gas                                 Oil                                 Total Depth                                 

## PRODUCTION

1st 24 hrs. Nat.                                 1st 24 hrs. after shot                                 Gas                                  Cu. Ft.Dry Hole                                 Abandoned                                 

Date

OCT 26 1940

19

S. J. LEWIS Scout

Map No. 17 Sec. 12 Twp. 23 R. 14EWell No. 2 StuckeyHuey etal Company Contractor**COMPLETED**

SE NE SE NW

 Ft. from N. Line880 Ft. from S. Line330 Ft. from E. Line Ft. from W. Line**SECTION PLAT**

|  |  |  |  |
|--|--|--|--|
|  |  |  |  |
|  |  |  |  |
|  |  |  |  |
|  |  |  |  |

**MISCELLANEOUS**Location Rig up 

Drilling and Remarks:

*Wier 1556**6" C 1584**P.A 1592.**1000 Acid**Pump 50 oil 100 Water**35° Gr***RECORD**Cased  in.,  ft.Sand Gas Oil Total Depth 1594**PRODUCTION**1st 24 hrs. Nat. 1st 24 hrs. after shot Gas  Cu. Ft.Dry Hole Abandoned 

Date

DEC 11 1940 19

S. J. LEWIS Scout