


Kansas

Map No. _____ Sec. *14* Twp. *23* R. *13*

Well No. *4* *Elliott* Farm
Manhattan Company

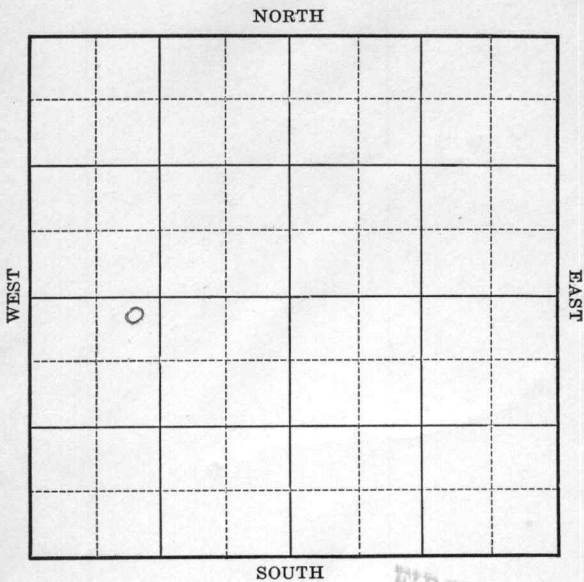

FIRST REPORT
COMPLETED

Location _____

Drilling Remarks:

RECORD

Cased _____ in. _____ ft.

Sand _____

Gas _____

Oil _____

Total Depth _____

Rig Up _____

Drilling Remarks:

PRODUCTION

1st 24 hrs. Nat. _____

1st 24 hrs. after shot _____

Gas _____ cu. ft.

Dry Hole _____

Abandoned _____

Map No. K Sec. 14 Twp. 23 R. 13


Well No. 4 Elliott Farm
Manhattan Company

200 Ft. from N. Line

_____ Ft. from S. Line

1120 Ft. from E. Line

_____ Ft. from W. Line

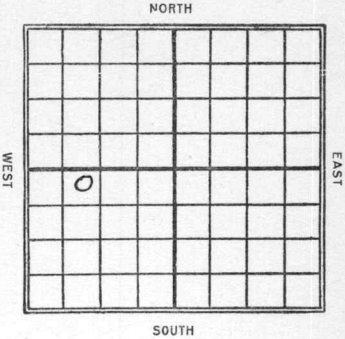

Date
1922

REPORT

11/24 Dlg. 1550'
12/3 Sand 1784-1835- Shot
140 gts. 50 Bbls.

Map No. **KANSAS** ¹⁷ Sec. **14** Twp. **23** R. **13**Well No. **4 - Elliot**
Manhattan Company

Contractor

FIRST REPORT

SECTION PLAT

200 Ft. from N. Line

Ft. from S. Line

1120 Ft. from E. Line

Ft. from W. Line

Location

Rig up

Drilling and Remarks:

RECORD

Cased in., ft.

Sand

Gas

Oil

Total Depth

PRODUCTION

1st 24 hrs. Nat.

1st 24 hrs. after shot

Gas Cu. Ft.

Dry Hole

Abandoned

Date

NOV 24 1922

191

M. A. BENEAR

Scout

Map No. **KANSAS** ¹⁷ Sec. ¹⁴ Twp. ²³ R. ¹³Well No. ⁴ *Elliot**Manhattan* Company

Contractor

COMPLETED SECTION PLAT*200* Ft. from N. Line

Ft. from S. Line

Ft. from E. Line

1120 Ft. from W. Line

Location

Rig up

Drilling and Remarks:

*1400 to shot***RECORD**

Cased _____ in., _____ ft.

Sand _____

Gas _____

Oil *1774-1735*

Total Depth _____

PRODUCTION

1st 24 hrs. Nat. _____

1st 24 hrs. after shot *50*

Gas _____ Cu. Ft.

Dry Hole _____

Abandoned _____

Date

DEC 3 1922**M. A. BENEAR**

191

Scout