


*Greenwood*

Map No. *Kansas* Sec. *33* Twp. *27* R. *13 E*

Well No. *1 Lessey* Farm

*O. W. Culp* Company

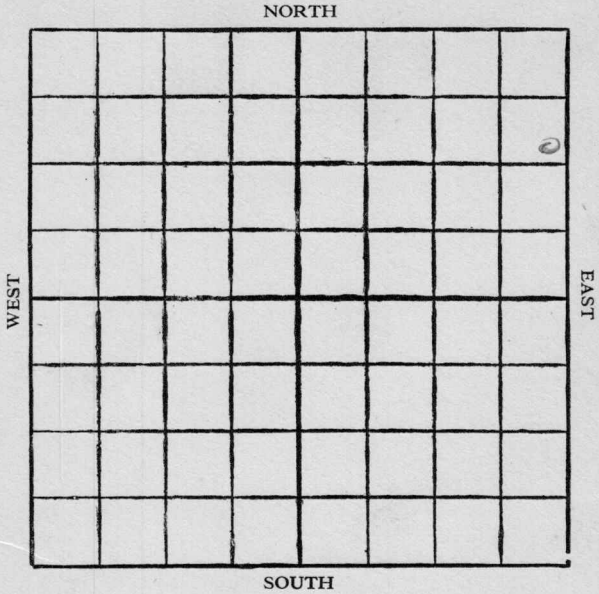

Location .....

Rig Up .....

Drilling Remarks

Drilling Remarks

.....

.....

**RECORD**

**PRODUCTION**

Cased..... in. .... ft.

1st 24 hrs. Nat.....

Sand .....

1st 24 hrs. after shot.....

Gas .....

Gas..... cu. ft.

Oil .....

Dry Hole.....

Total Depth.....

Abandoned .....

*Greenwood*

Map No. *Kansas* Sec. *33* Twp. *27* R. *13E*

Well No. *1 Lessey* Farm


*O. W. Culp* Company

*1070* Ft. from N. Line

\_\_\_\_\_ Ft. from S. Line

*250* Ft. from E. Line

\_\_\_\_\_ Ft. from W. Line

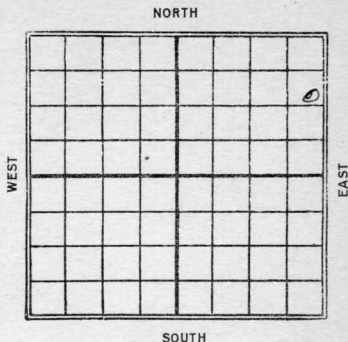

Date	REPORT
<i>1927</i>	
<i>5/18</i>	<i>Rigging up machine</i>
<i>5/25</i>	<i>_____</i>
<i>6/1</i>	<i>_____</i>
<i>6/7</i>	<i>_____</i>
<i>6/15</i>	<i>_____</i>
<i>6/22</i>	<i>_____</i>
<i>6/29</i>	<i>_____</i>
<i>7/7</i>	<i>_____</i>
<i>7/13</i>	<i>_____</i>
<i>7/20</i>	<i>Rigged up + S.D.</i>
<i>7/28</i>	<i>_____</i>
<i>8/4</i>	<i>Top line 1480 S.D. 1490</i>
<i>8/10</i>	<i>_____</i>
<i>8/18</i>	<i>_____</i>
<i>8/24</i>	<i>Drlg 1525</i>
<i>9/1</i>	<i>Shut down 1662-</i>
<i>9/7</i>	<i>Top line 1480-S.D. 1662-</i>
<i>9/14</i>	<i>_____</i>
<i>9/29</i>	<i>_____</i>
<i>10/6</i>	<i>_____</i>
<i>10/12</i>	<i>_____</i>
<i>10/19</i>	<i>_____</i>

10/27 - Top lime 1480'  
S.D. 1662'

11/2 - \_\_\_\_\_

11/9 \_\_\_\_\_

11/16 - top lime 1480'  
top 2nd. bk. 1780  
H.F.W. S. & A. 1790

*Sherwood*

Map No. *nominal* **KANSAS** Sec. *33* Twp. *27* R. *13*

Well No. *1* *Ledney*

*O.W. Culp* Company

Contractor

**FIRST REPORTS**

**SECTION PLAT**

*1070* Ft. from N. Line

\_\_\_\_\_ Ft. from S. Line

*250* Ft. from E. Line

\_\_\_\_\_ Ft. from W. Line

			<i>0</i>

Location \_\_\_\_\_

Rig up \_\_\_\_\_

Drilling and Remarks:

*Digging up mch;*

**RECORD**

Cased \_\_\_\_\_ in., \_\_\_\_\_ ft.

Sand \_\_\_\_\_

Gas \_\_\_\_\_

Oil \_\_\_\_\_

Total Depth \_\_\_\_\_

**PRODUCTION**

1st 24 hrs. Nat. \_\_\_\_\_

1st 24 hrs. after shot \_\_\_\_\_

Gas \_\_\_\_\_ Cu. Ft.

Dry Hole \_\_\_\_\_

Abandoned \_\_\_\_\_

Date

**MAY 18 1927**

**CHAS. L. SHERWOOD**

**192**

Scout

*Senwood*  
 KANSAS  
 Map No. \_\_\_\_\_ Sec. *33* Twp. *27* R. *13*  
 Well No. *Lesney*  
*O.W. Culp* \_\_\_\_\_ Company

\_\_\_\_\_ Contractor

**COMPLETED**

*1070* \_\_\_\_\_ Ft. from N. Line  
 \_\_\_\_\_ Ft. from S. Line  
*250* \_\_\_\_\_ Ft. from E. Line  
 \_\_\_\_\_ Ft. from W. Line

**ABANDONED**

**SECTION PLAT**

			<i>0</i>

Location \_\_\_\_\_

Rig up \_\_\_\_\_

**Drilling and Remarks:**

*Top line 1480*  
*Top 2nd bk*  
*1780 AFW*  
*1790*

**RECORD**

Cased \_\_\_\_\_ in., \_\_\_\_\_ ft.  
 Sand \_\_\_\_\_  
 Gas \_\_\_\_\_  
 Oil \_\_\_\_\_  
 Total Depth *1790*

**PRODUCTION**

1st 24 hrs. Nat. \_\_\_\_\_  
 1st 24 hrs. after shot \_\_\_\_\_  
 Gas \_\_\_\_\_ Cu. Ft.  
 Dry Hole   
 Abandoned

Date

*NOV. 13 1927*