


Section 13 Township 33 Range 34WWell No. #1 ReimerCompany Cabot Carbon

NORTH

WEST

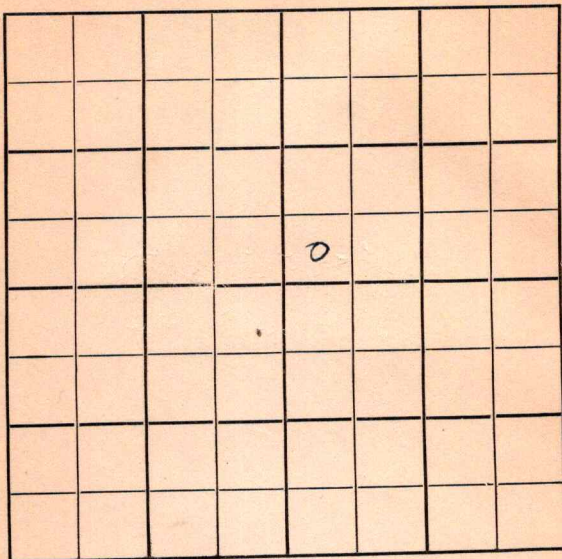

EAST

SOUTH

KANSAS

Seward
34-W

13

33

Sec. _____ Twp. _____ R. _____

#1 Reimer

Well No. _____ Farm _____

Cabot Carbon

Company _____

Hugoton _____ Contractor _____


_____ Ft. from N. Line

330 _____ Ft. from S. Line

_____ Ft. from E. Line

330 _____ Ft. from W. Line

SW SW NE

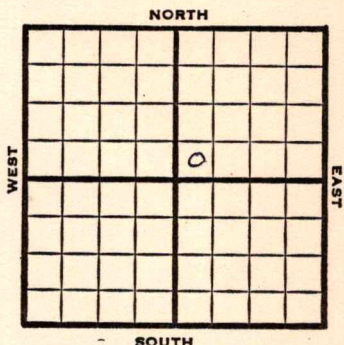

1950

Elev 2877' REPORT

10/18 Location

12/13 Spud 10-16-50

10" @ 488

7" @ 2581

TD 2682

Her 2575-2609 Krider 2615-41

13000 total acid

Comp 15,415,000 gas 424#

Completed

COMPLETED

Sec. **13** (Blk.) **33** (Sur.) **34W** Map No.

Operator Cabot Carbon

Well No. 1 Farm Reimer

Elev.	Location	SWSW NE

FIRST REPORT

330 Ft. From S Line NE

330 Ft. From W Line Quarter

1st. Report OCT 18 1950

Completion

Remarks

Spudding Date _____

Drlg. Data Hugoton Pool

Location

J. E. TYRA

Kansas

(Blk.)
(Twp.)

Cabot Carbon

1 Farm Reimer

2877	Location	SW SW NE
------	----------	----------

COMPLETE

330 Ft. From S Line NE

330 Ft. From W Line Quarter

1st. Report

Completion DEC 13 1950

Remarks	Hugoton Pool
---------	--------------

Spudding Date 10-16-50

Drig. Data	Gas well	TD 2682
------------	----------	---------

10" @ 488 7" @ 2581 TD 2682

Her. 2575-2609 Krider 2615-41

13000 total acid Comp. 15,415,000 gas 424#

J. E. TYRA