

WEST

EAST

SOUTH

Drilling Remarks:

Rig up _____

Drilling Remarks:

RECORD

Cased _____ in. _____ ft.

Sand _____

Gas _____

Oil _____

Total Depth_____

PRODUCTION

1st 24 hrs Nat. _____

1st 24 hrs. after shot_____

Gas _____ cu. ft.

Dry Hole_____

Abandoned _____

Map No. _____ Sec. 14 Twp. 23 R. 13

Well No. 7 Elliott Farm _____
Manhattan Company _____

NORTH

_____ Ft. from N. Line


760 Ft. from S. Line

_____ Ft. from E. Line

200 Ft. from W. Line

WEST

EAST

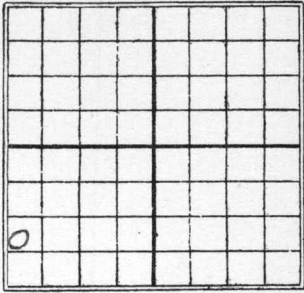

SOUTH

Date
1923

REPORT

3/2 R.O.S.
3/30 Top line 1780 Sand
1800-28- I.D. 1834
shot 100 gts. 50 lbs.

Map No. **KANSAS** ¹⁷ Sec. ¹⁴ Twp. ²³ R. ¹³Well No. ^{7 Elliott}
Manhattan Company

Contractor

COMPLETED SECTION PLAT

Ft. from N. Line

760 Ft. from S. Line

Ft. from E. Line

200 Ft. from W. Line

Location

Rig up

Drilling and Remarks:

Top Line 1780'
sand { 1800
{ 1828
T.D. 1834
shot 100/5

RECORD

Cased _____ in., _____ ft.

Sand _____

Gas _____

Oil _____

Total Depth _____

PRODUCTION

1st 24 hrs. Nat. _____

1st 24 hrs. after shot _____

Gas _____ Cu. Ft.

Dry Hole _____

Abandoned _____

Date

MAR 30 1923

M. A. BENEAR

191

Scout

NOTED FOR COLLECTION
 RETURNED FOR COLLECTION

Map No. **KANSAS** 17 Sec. 14 Twp. 23 R. 13

Well No. 7 Elliott

Manhattan Company

Contractor

FIRST REPORT

_____Ft. from N. Line

760 Ft. from S. Line

_____Ft. from E. Line

200 Ft. from W. Line

SECTION PLAT

Location _____

Rig up _____

Drilling and Remarks:

R.O.B.

RECORD

Cased _____ in., _____ ft.

Sand _____

Gas _____

Oil _____

Total Depth _____

PRODUCTION

1st 24 hrs. Nat. _____

1st 24 hrs. after shot _____

Gas _____ Cu. Ft.

Dry Hole _____

Abandoned _____

Date

MAR 2 1923

191

M. A. BENEAR

Scout