

Sedgwick
28 1E

Map No. Sec. 29 Twp. 28 R. 1E

Well No. 6-Nolan Farm

Dickey Oil Company


 Ft. from N. Line

990 Ft. from S. Line

990 Ft. from E. Line

 Ft. from W. Line

Elev. 1274

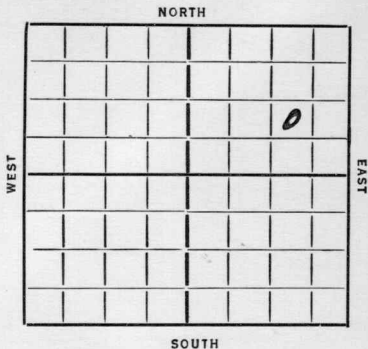

REPORT

~~1/18~~
 1/8 B. Pot Rig
 1/17 12" 85 WOC
 1/24 July 2290
 1/31 Top Chat 3079 6" 3080 Rust
 2/7 TD 3115 H.F.O.
 2/14 TD 3121 2000' O.T.H.
 2000 acid
 2/19 T Chat 3079
 TD 3121
 2000 acid
 515 Bbls.

COMPLETED

Sedgwick
Form 26-1M Bks. 9-28

KANSAS

Map No. 12 Sec. 20 Twp. 28 R. 1 E

Well No. 6 - Nolan

Dickey Oil Company
Contractor

SECTION PLAT

..... Ft. from N. Line

990 Ft. from S. Line

990 Ft. from E. Line

..... Ft. from W. Line

			0

FIRST REPORT

Location.....

Rig up.....

Drilling and Remarks:
B. Rot. Rig

RECORD

Cased..... in., ft.

Sand.....

Gas.....

Oil.....

Total Depth.....

PRODUCTION

1st 24 hrs. Nat.....

1st 24 hrs. after shot.....

Gas..... Cu. Ft.

Dry Hole.....

Abandoned.....

Date

JAN 8 1936 192

ORVAL MANNSCHRECK

Scout

Map No. *12* Sec. *20* Twp. *28* R. *1E*

Well No. *6-Molan*

Dickey Company

Contractor

COMPLETE

SECTION PLAT

			0

..... Ft. from N. Line

990 Ft. from S. Line

990 Ft. from E. Line

..... Ft. from W. Line

RECORD

Location.....

Cased..... in., ft.

Rig up.....

Sand *T. Chat 3079*

Drilling and Remarks:

Gas.....

2000 and

Oil.....

Total Depth *3121*

PRODUCTION

515 fbls

1st 24 hrs. Nat.....

1st 24 hrs. after shot.....

Gas..... Cu. Ft.

Dry Hole.....

Abandoned.....

Date

ORVAL MANNSCHRECK

2-19-36 192

Scout