


Section 33 Township 33 Range 33W

Well No. #1 Salley

Company Kuhn et al

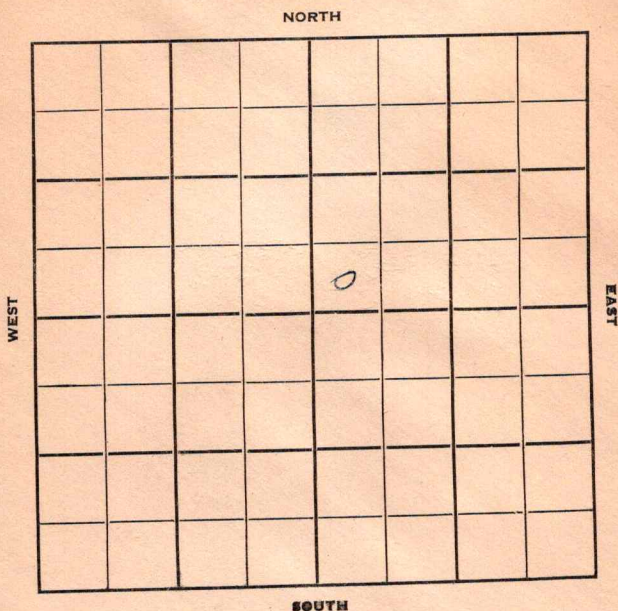

Seward

KANSAS

Sec. 33 Twp. 33 R. 33W

Well No. #1 Salley Farm

Kuhn etal Company

Contractor

Hugoton Pool


 Ft. from N. Line

200' Ft. from S. Line

 Ft. from E. Line

400' Ft. from W. Line

SW NE

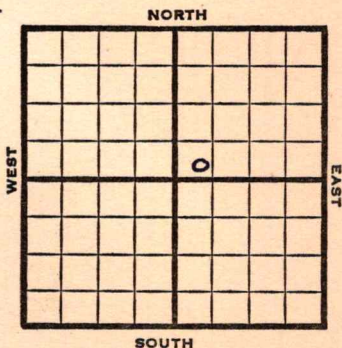

1950	Elev 2818' REPORT
8/30	Spud 8-24-50 10" @ 605' Shut down @ 1460
12/6	10" @ 605 7" @ 2525 TD 2690 15000 A Comp 7,348,000 gas Completed COMPLETED

County Seward State KansasSec. 33 (Blk.) 33 (Sur.) 33W Map No.Operator Kuhn et al.Well No. 1 Farm SalleyElev. 2818 Location SW NE

FIRST REPORT


200 Ft. From S Line NE400 Ft. From W Line Quarter1st. Report AMGG 3300 1950

Completion

Remarks

Spudding Date 8-24-50Drlg. Data Hugoton Pool10" @ 605 Shut down @ 1460

J. E. TYRA

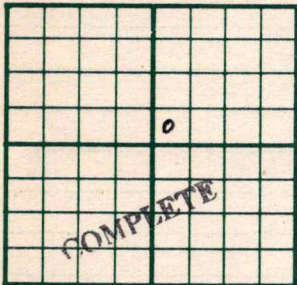County Seward State KansasSec. 33 (Blk.) 33 (Sur.) 33W Map No.Operator Kuhn et al.Well No. 1 Farm SalleyElev. 2818 Location SW NE200 Ft. From S Line NE400 Ft. From W Line Quarter

1st. Report

Completion DEC 6 1950Remarks Hugoton PoolSpudding Date 8-24-50Drlg. Data Gas well TD 269010" @ 605 7" @ 2525 TD 2690 15000 AComp. 7,348,000 gas

J. E. TYRA