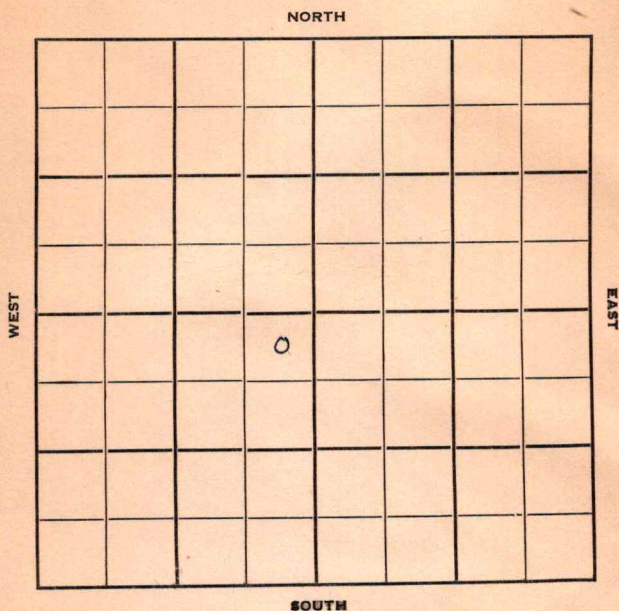


Section 18 Township 33 Range 33-WWell No. #1 SpeakmanCompany Cabot Carbon

Seward

KANSAS

Sec. 18 Twp. 33 R. 33W

Well No. #1 Speakman Farm

Cabot Carbon Company

Contractor

Hugoton Pool


330' Ft. from N. Line

_____ Ft. from S. Line

330' Ft. from E. Line

_____ Ft. from W. Line

NE NE SW

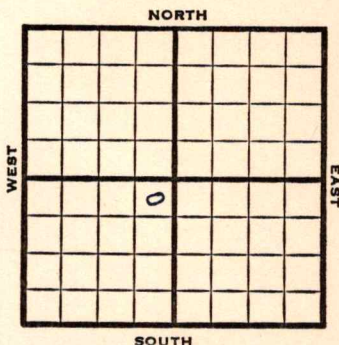

1950

Elev 2871'

REPORT

10/25

10" @ 515'

Spud 10-8-50

12/6

10" @ 515'

Her 2588

7" @ 2595

TD 2675

1000 A

Comp 11,696,000 gas

Completed

COMPLETED

J. E. TYRA

