


Section 8 Township 33 Range 33W

Well No. #1-8 Bryant

Company Cabot Carbon

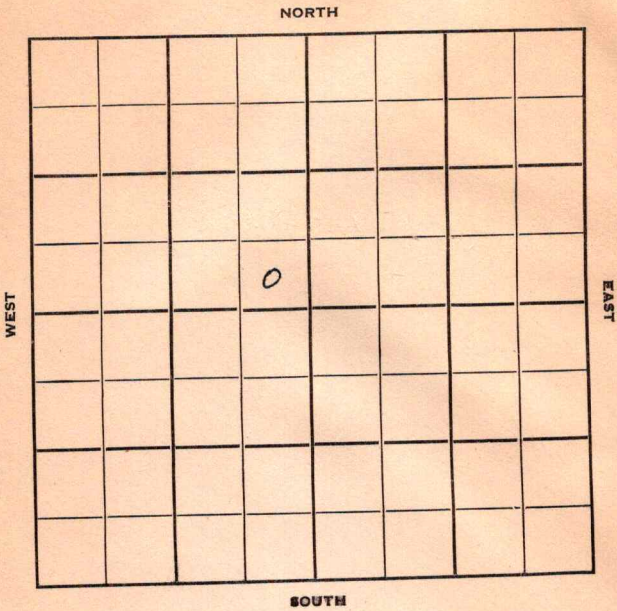

Seward

KANSAS

33W

Sec. 8 Twp. 33 R. 33W

Well No. #1-8 Bryant Farm

Cabot Carbon Company

Contractor

Hugoton Pool


 Ft. from N. Line

330' Ft. from S. Line

330' Ft. from E. Line

 Ft. from W. Line

SE SE NW

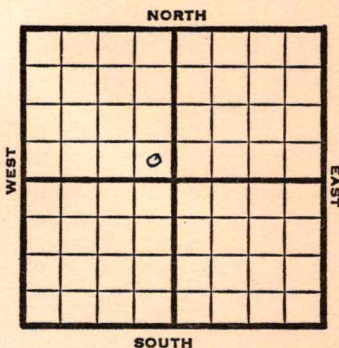

1950

Elev 2813' REPORT

9/27 Location

12/6 7" @ 2541

TD 2648

PB 2633


Krider 2641

Comp 14,368,000 gas 434#

Completed

COMPLETED

J. E. TYRA

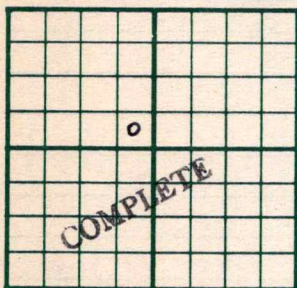County Seward State KansasSec. 8 (Blk.) 33 (Sur.) 33W Map No.Operator Cabot CarbonWell No. 1-8 Farm BryantElev. 2813 Location SE SE NW330 Ft. From S Line NW330 Ft. From E Line Quarter1st. ReportCompletion DEC 6 1950Remarks Hugoton PoolSpudding Date 9-28-50Drilg. Data Gas well TD 26487" @ 2541 TD 2648 PB 2633 Krider 2641Comp. 14,368,000 gas 434#

J. E. TYRA