

Map No. K Sec. 14 Twp. 23 R. 13

Well No. 9 Elliot Farm

Manhattan Dis Company

NORTH

WEST

EAST

SOUTH

Location _____

Drilling Remarks:

Rig Up _____

Drilling Remarks:

RECORD

Cased_____ in._____ft.

Sand _____

Gas _____

Oil _____

Total Depth_____

PRODUCTION

1st 24 hrs. Nat. _____

1st 24 hrs. after shot_____

Gas _____ cu. ft.

Dry Hole _____


Abandoned _____

Map No. 75 Sec. 14 Twp. 23 R. 13Well No. 9 Elliott Farm
Manhattan Oil Company

Ft. from N. Line

200 Ft. from S. Line200 Ft. from E. Line

Ft. from W. Line

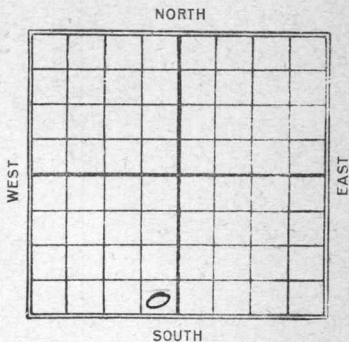

REPORT

~~1/24~~
 3/14 Ray
 4/23 Top Line - 1740'
 Ray 1770-1794
 74 - 1800'
 80/swab - 110 Bbls

Map No. KANSAS 17 Sec. 14 Twp. 23 R. 13

Well No. # 9 E Elliott

Manhattan Oil Company

Contractor

FIRST REPORT

SECTION PLAT

_____ Ft. from N. Line

200 Ft. from S. Line

200 Ft. from E. Line

_____ Ft. from W. Line

Location _____

Rig up _____

Drilling and Remarks:

R.O. G.

RECORD

Cased _____ in., _____ ft.

Sand _____

Gas _____

Oil _____

Total Depth _____

PRODUCTION

1st 24 hrs. Nat. _____

1st 24 hrs. after shot _____

Gas _____ Cu. Ft.

Dry Hole _____

Abandoned _____

Date

MAR 14 1924

M. A. BENEAR

_____ 192_____

_____ Scout

Map No. **KANSAS** 17 Sec. **14** Twp. **23** R. **13**
 Well No. **# 9 Elliott**
Manhattan Company

Contractor

COMPLETED SECTION PLAT

_____ Ft. from N. Line

200 Ft. from S. Line**200** Ft. from E. Line

_____ Ft. from W. Line

Location _____

Rig up _____

Drilling and Remarks:

Tap L. 1746**Pay 1770-1794'****T.D. 1800'****80/swabbing**
110 bbls

RECORD

Cased _____ in., _____ ft.

Sand _____

Gas _____

Oil _____

Total Depth _____

PRODUCTION

1st 24 hrs. Nat. _____

1st 24 hrs. after shot _____

Gas _____ Cu. Ft.

Dry Hole _____

Abandoned _____

Date

APR 23 1924**M. A. BENEAR****192**

Scout