
Ridgwick

Form 51—5M—5-34—Palace

Map No. KANSAS Sec. 20 Twp. 28 R. 1E

Well No. 1 Riley Farm

Dickey Oil Company

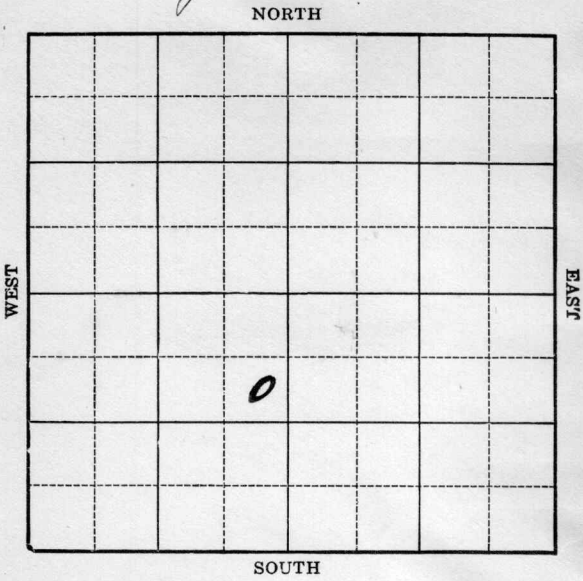

Location

Drilling Remarks

Rig Up

Drilling Remarks

RECORD

Cased ..... in. ..... ft.

Sand .....

Gas .....

Oil .....

Total Depth .....

PRODUCTION

1st 24 hrs. Nat. .....

1st 24 hrs. after shot .....

Gas ..... cu. ft. .....

Dry Hole .....

Abandoned .....

Form 252-A
5M 7-34 MPC

Sedgwick

Map No. KANSAS Sec. 20 Twp. 28 R. 1E

Well No. 1 Riley Farm


Dickey Oil Company

990 Ft. from N. Line

_____ Ft. from S. Line

330 Ft. from E. Line

_____ Ft. from W. Line

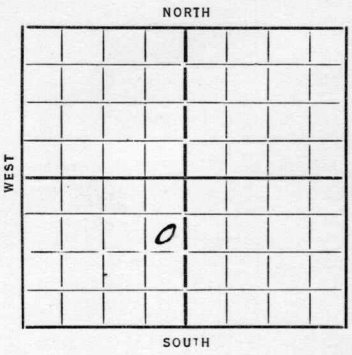

Date 1934	REPORT
11/14	Moving in
11/22	Spudd
11/28	Oly 1400 10" 88
12/6	h 3083
12/13	Chat 3097 TD 3104
	6" 3092 Rust
12/21	3118 1800' fluid
	TD 3124 Acidize
12/26	Chat 3097 TD 3124
	1000 acid 589 Bbls.

COMPLETED

Form 26—1M Bks.—2-29

Kansas

Map No. 12 Sec. 20 Twp. 28 R. 1 E

Well No. 1 - Riley

Duhey Oil Company

Contractor

FIRST REPORTS


SECTION PLAT

990 Ft. from N. Line

Ft. from S. Line

330 Ft. from E. Line

Ft. from W. Line

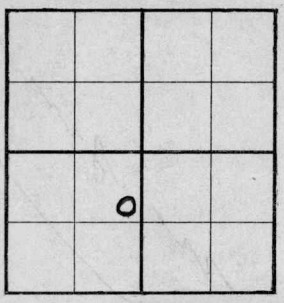

Location

Rig up

Drilling and Remarks:

Moving in

RECORD

Cased in., ft.

Sand

Gas

Oil

Total Depth

PRODUCTION

1st 24 hrs. Nat.

1st 24 hrs. after shot

Gas Cu. Ft.

Dry Hole

Abandoned

Date

11-14-37 19

ORVAL MANNSCHRECK Scout

Form 26—1M Bks. 9-28

Kirkpatrick .KANSAS

Map No. 12 Sec. 20 Twp. 28 R. 1E

Well No. 1- Riley

Hickey Oil Company

.....Contractor

COMPLETED


990 Ft. from N. Line

.....Ft. from S. Line

330 Ft. from E. Line

.....Ft. from W. Line

SECTION PLAT

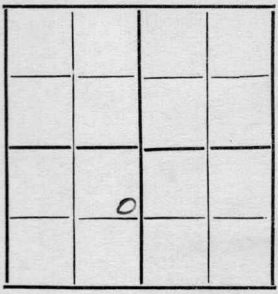

Location.....

Rig up.....

Drilling and Remarks:

1000 and

589 bbls

RECORD

Cased.....in., ...ft.

Sand Chat 3097

Gas.....

Oil.....

Total Depth 3124

PRODUCTION

1st 24 hrs. Nat.....

1st 24 hrs. after shot.....

Gas.....Cu. Ft.

Dry Hole.....

Abandoned.....

Date

12-26-34 192....

ORVAL MANNSCHRECK Scout