

Sedgwick
 Form 51-5M-9-28-27423
 Map No. KANSAS Sec. 20 Twp. 28 R. 1E
 Well No. A. J. Robbins Farm
H. L. Payne Company

NORTH

WEST

EAST

							0

SOUTH

Location.....
 Drilling Remarks

Rig Up.....
 Drilling Remarks

RECORD

Cased..... in..... ft.
 Sand.....
 Gas.....
 Oil.....
 Total Depth.....

PRODUCTION

1st 24 hrs. Nat.....
 1st 24 hrs. after shot.....
 Gas..... cu. ft.....
 Dry Hole.....
 Abandoned.....


Sidewick
 Map No. KANSAS Sec. 20 Twp. 28 R. 1E
 Well No. 2- Robbins Farm
White Payle Company

990 Ft. from N. Line

_____ Ft. from S. Line

330 Ft. from E. Line

_____ Ft. from W. Line

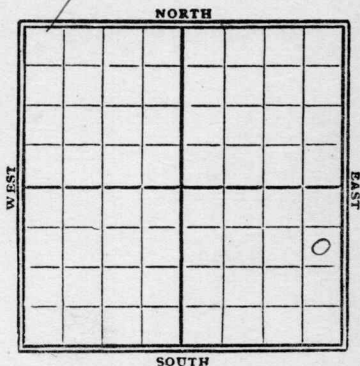

1929

Date

REPORT

Date	REPORT
7/2	Location
7/10	Bldy Pay
7/17	Rig up
7/24	Wrlly 500'
7/31	" 1325'
8/7	fsq 2035'
8/14	HFW 2275-2317 Wrlly 2625'
8/21	Chat 3099-3101- H.F.O. flowed 20 bbls & swabbed 45 bbls in 4 hrs.
8/28	Chat 3099-3101' TD 3101' swab 216 bbl oil Pump.

Map No. **KANSAS** Sec. *20* Twp. *28* R. *1E*

Well No. *2 Roxbins*

White Eagle Company

Contractor

SECTION PLAT

990 Ft. from N. Line

..... Ft. from S. Line

330 Ft. from E. Line

..... Ft. from W. Line

			o

FIRST REPORTS

Location *✓*

Rig up

Drilling and Remarks:

RECORD

Cased.....in.,ft.

Sand.....

Gas.....

Oil.....

Total Depth.....

PRODUCTION

1st 24 hrs. Nat.....

1st 24 hrs. after shot.....

Gas.....Cu. Ft.

Dry Hole.....

Abandoned.....

Date

JUL 2 1929
.....192.....

S. J. LEWIS Scout

Map No. *12* **KANSAS** Sec. *20* Twp. *28* R. *15*

Well No. *2 Robbins*

White Eagle Company

Contractor

SECTION PLAT

990 Ft. from N. Line

..... Ft. from S. Line

330 Ft. from E. Line

..... Ft. from W. Line

COMPLETED

Location.....

Rig up.....

Drilling and Remarks:

Cha 83099-3101

Cha 8216 886

RECORD

Cased..... in., ft.

Sand.....

Gas.....

Oil.....

Total Depth *3101*

PRODUCTION

1st 24 hrs. Nat.....

1st 24 hrs. after shot.....

Gas..... Cu. Ft.

Dry Hole.....

Abandoned.....

Date

AUG 28 1920

S. J. LEWIS

Scout