


Map No. KANSAS Sec. 20 Twp. 28 R. 1E
Well No. 3- Robbins Farm
White Eagle Company

NORTH

WEST

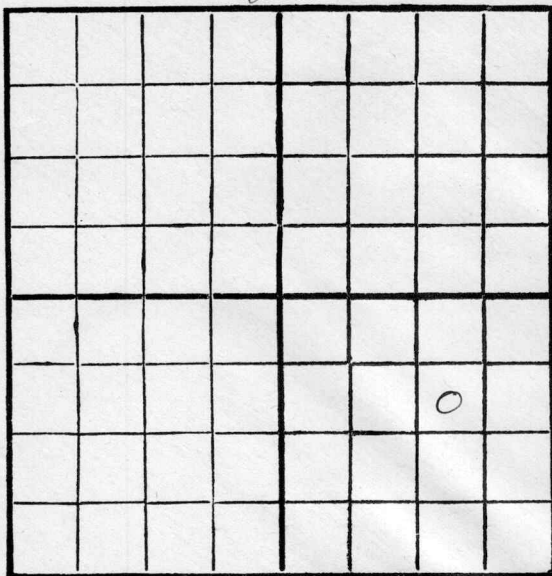

EAST

SOUTH

Location _____

Drilling Remarks _____

Rig Up _____

Drilling Remarks _____

RECORD

Cased _____ in. _____ ft.

Sand _____

Gas _____

Oil _____

Total Depth _____

PRODUCTION

1st 24 hrs. Nat. _____

1st 24 hrs. after shot _____


Gas _____ cu. ft.

Dry Hole _____

Abandoned _____

Map No. KANSAS Sec. 20 Twp. 28 R. 1E
Well No. 3 - Robbins Farm
White Payle Company

990 Ft. from N. Line
____ Ft. from S. Line
990 Ft. from E. Line
____ Ft. from W. Line

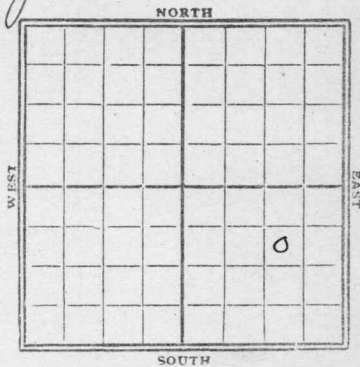

1929

Date

REPORT

9/18	Drill
9/25	ROC
10/2	Bldy Ry
10/19	Spud
10/16	Wlg 600'
10/23	" 1570'
10/30	" 2200'
11/6	" 2810'
11/13	2nd Chat 3095 HFW 3135-llg
11/20	Chat 3095 HFW
11/27	TD 3135' Dry & Abandoned

Map No. KANSAS Sec. 20 Twp. 28 R. 1EWell No. 3 RoydinsWhite Eagle Company

Contractor

SECTION PLAT

990 Ft. from N. Line

Ft. from S. Line

990 Ft. from E. Line

Ft. from W. Line

FIRST REPORTS

Location

Rig up

Drilling and Remarks:

Cellar

RECORD

Cased.....in.,ft.

Sand.....

Gas.....

Oil.....

Total Depth.....

PRODUCTION

1st 24 hrs. Nat.....

1st 24 hrs. after shot.....

Gas.....Cu. Ft.

Dry Hole.....

Abandoned.....

Date

SEP 18 1929

192

S. J. LEWIS Scout

Map No. KANSAS Sec. 20 Twp. 28 R. 1E

Well No. 3 Rox Lines

White Eagle Company

Contractor

SECTION PLAT

990 Ft. from N. Line

..... Ft. from S. Line

990 Ft. from E. Line

..... Ft. from W. Line

			0

ABANDONED

Location.....

Rig up.....

Drilling and Remarks:

Chas 3095 N-1-N

RECORD

Cased.....in.,ft.

Sand.....

Gas.....

Oil.....

Total Depth 3135

PRODUCTION

1st 24 hrs. Nat.....

1st 24 hrs. after shot.....

Gas.....Cu. Ft.

Dry Hole.....

Abandoned.....

Date

NOV 27 1928

192

S. J. LEWIS

Scout