


Map No. Kansas Sec. 14 Twp. 23 R. 13
 Well No. 13 Elliott Farm
Manhattan Oil Company

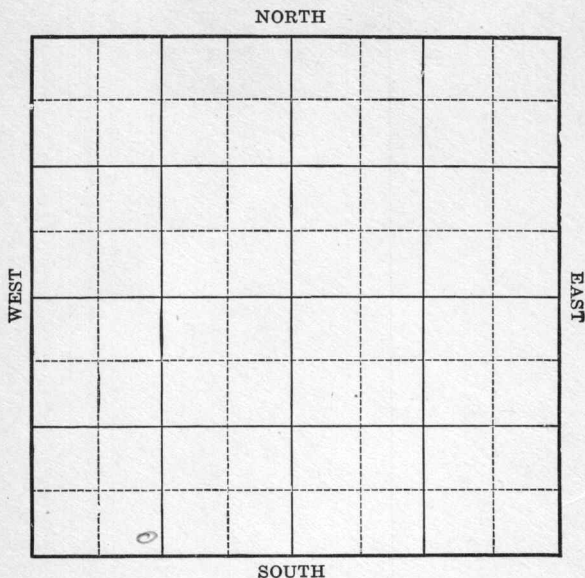

Location _____

Drilling Remarks

Rig Up _____

Drilling Remarks

RECORD

Cased _____ in. _____ ft.

Sand _____

Gas _____

Oil _____

Total Depth _____

PRODUCTION

1st 24 hrs. Nat. _____

1st. 24 hrs. after shot _____

Gas _____ cu. ft.

Dry Hole _____


Abandoned _____

Map No. Kansas Sec. 14 Twp. 23 R. 13Well No. 13 Elliott FarmManhattan oil Company

Ft. from N. Line

200 Ft. from S. Line

Ft. from E. Line

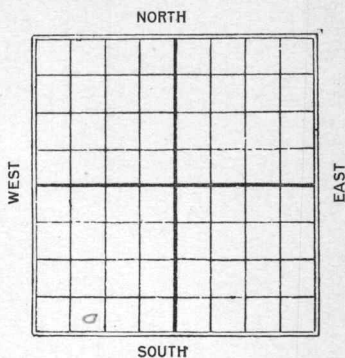760 Ft. from W. Line

Date

REPORT

19255/8Rig up5/29Top Line 17841804-1830 120 gts35 Bbls T.D. 1834

Map No. 17 Kansas Sec. 14 Twp. 23 R. 13

Well No. 13 Elliott

Manhattan Oil Co Company

Contractor

SECTION PLAT

_____ Ft. from N. Line

200 Ft. from S. Line

_____ Ft. from E. Line

760 Ft. from W. Line

FIRST REPORTS

Location _____

Rig up _____

Drilling and Remarks:

RECORD

Cased _____ in., _____ ft.

Sand _____

Gas _____

Oil _____

Total Depth _____

PRODUCTION

1st 24 hrs. Nat. _____

1st 24 hrs. after shot _____

Gas _____ Cu. Ft.

Dry Hole _____

Abandoned _____

Date

MAY 8 1925

192

CHAS. L. SHERWOOD

Scout

Map No. 54 Sec. 14 Twp. 23 R. 13Well No. 13 ElliottMcIntosh oil Co. Company

Contractor

COMPLETED

SECTION PLAT

Ft. from N. Line

200 Ft. from S. Line

Ft. from E. Line

760 Ft. from W. Line

Location -----

Rig up -----

Drilling and Remarks:

SET 6" 1784' tap
 line 1784' day
 1804-1830'

120/35 b/s

RECORD

Cased ----- in., ----- ft.

Sand -----

Gas -----

Oil -----

Total Depth 1834'

PRODUCTION

1st 24 hrs. Nat. -----

1st 24 hrs. after shot -----

Gas ----- Cu. Ft.

Dry Hole -----

Abandoned -----

Date

MAY 29 1925

192

CHAS. L. SHERWOOD

Scout