
Form 51—10M—8-19—CroMac

Map No. 1 Sec. 14 Twp. 23 R. 13

Well No. 1 R. Elliott Farm

Manhattan Oil Company

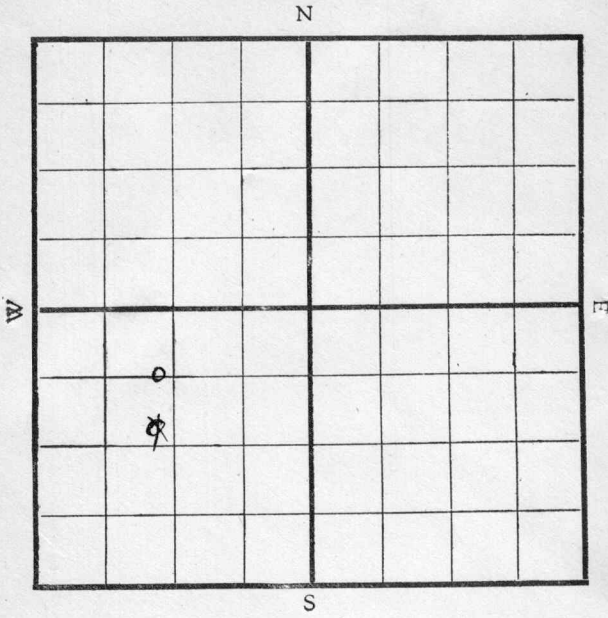

COMPLETED

Location _____

Drilling Remarks:

Rig Up _____

Drilling Remarks:

RECORD

Cased _____ in. _____ ft.

Sand _____

Gas _____

Oil _____

Total Depth _____

PRODUCTION

1st 24 hrs. Nat. _____

1st 24 hrs. after shot _____

Gas _____ cu. ft.

Dry Hole _____

Abandoned _____

Form 252A 8M-11-20 PALACE-TULSA 4617

Map No. _____ Sec. 14 Twp. 23 R. 13

Well No. 1 R. E. Elliott Farm


Manhattan Oil Company

660 Ft. from N. Line

_____ Ft. from S. Line

_____ Ft. from E. Line

1120 Ft. from W. Line

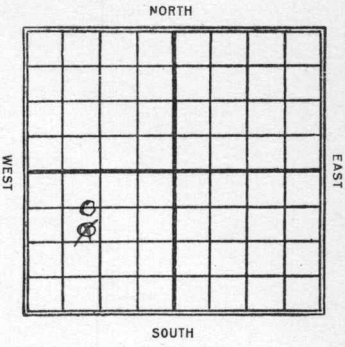

Date 1922	REPORT COMPLETED
1/15	Spudding.
2/4	Top sand 1785-1878 Ftd. Shootery 130 qts - Filled up 500'
2/8	1785-1878- Shot 130 qts - 40 bbls


Form O415-500 Books-2-25-21-100

Map No. K17 Sec. 14 Twp. 23 R. 13

Well No. 1 R. Elliott

Manhattan Oil Company.

1120' from N NORTH 1120 from W.

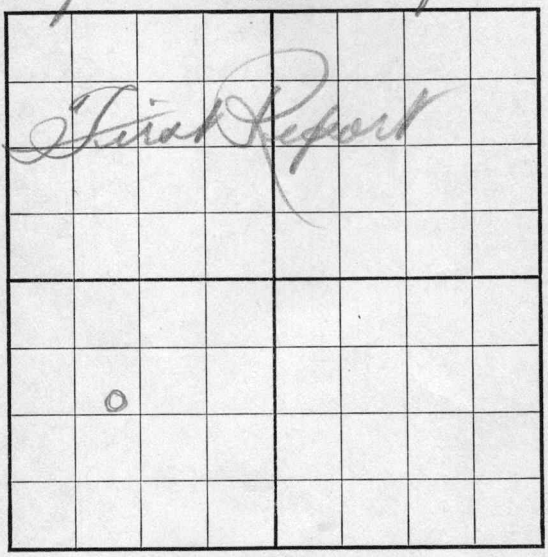

Location

Rig up

Drilling and Remarks:

Spudding

RECORD

Cased in., ft.

Sand

Gas

Oil

Total Depth

PRODUCTION

1st 24 hrs. Nat.

1st 24 hrs. after shot

Gas Cu. Ft.

Dry Hole

Abandoned

State Kansas

Date 1/13 192 2 Scout

Form 26—1M—4-19—Mid-West

Map No. K17 Sec. 14 Twp. 23 R. 13


Well No. 1 E. Elliot

Manhattan Oil Company

Contractor

COMPLETED

SECTION PLAT

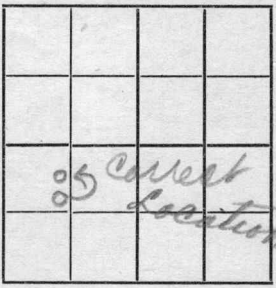

1660 Ft. from N. Line

Ft. from S. Line

Ft. from E. Line

1120 Ft. from W. Line

Location

Rig up

Drilling and Remarks:

sand 1785
1828 T.D.
shot 13 qts
making 40 Hrs

RECORD

Cased in., ft.

Sand

Gas

Oil

Total Depth

PRODUCTION

1st 24 hrs. Nat.

1st 24 hrs. after shot

Gas Cu. Ft.

Dry Hole

Abandoned

Date

FEB 18 1922 191

M. A. BENEAR Scout