
Form 51 5M 7-22 9573

Map No. _____ Sec. 22 Twp. 23 R. 10

Well No. 1 Tucker Farm

Mission Company

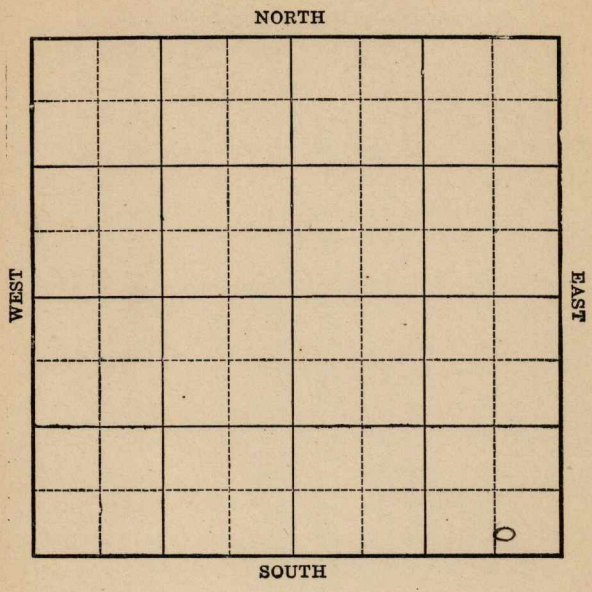

Location _____

Drilling Remarks:

Rig up _____

Drilling Remarks:

RECORD

Cased _____ in. _____ ft.

Sand _____

Gas _____

Oil _____

Total Depth _____

PRODUCTION

1st 24 hrs Nat. _____

1st 24 hrs. after shot _____

Gas _____ cu. ft.

Dry Hole _____

Abandoned _____

Form 252A 5M 4-22 8765

Map No. _____ Sec. 22 Twp. 23 R. 10

Well No. 1 Tucker Farm


Mission Company

_____ Ft. from N. Line

200 Ft. from S. Line

200 Ft. from E. Line

_____ Ft. from W. Line

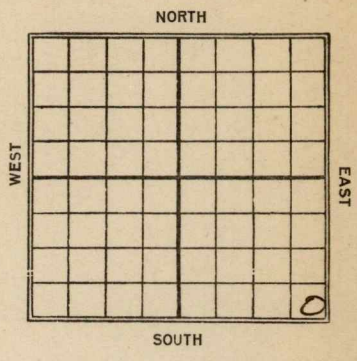

Date	REPORT
1923	
4/20	Location
6/10	Sand 2244-2313 - shot
	800 gts. 10 Bbls. TD 2331'

Form 26—1M—4-19—Mid-West

Map No. KANSAS 16 Sec. 22 Twp. 23 R. 10


Well No. 1 Tucker

Midwest Company

Contractor

FIRST REPORT

SECTION PLAT

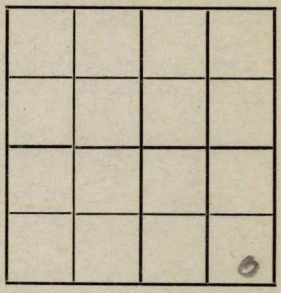

200 Ft. from N. Line

200 Ft. from S. Line

Ft. from E. Line

Ft. from W. Line

Location

Rig up

Drilling and Remarks:

RECORD

Cased in., ft.

Sand

Gas

Oil

Total Depth

PRODUCTION

1st 24 hrs. Nat.

1st 24 hrs. after shot

Gas Cu. Ft.

Dry Hole

Abandoned

Date

APR 20 1923

191 Scout

Form 26—1M Bks.—3-23—11959.

Map No. KANSAS 16 Sec. 22 Twp. 23 R. 10


Well No. 1 Tucker

Mission Oil Company

Contractor

COMPLETED

SECTION PLAT

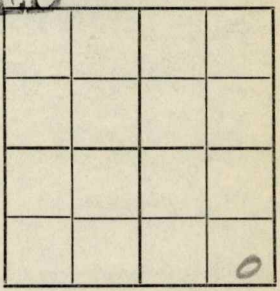

Ft. from N. Line

200 Ft. from S. Line

200 Ft. from E. Line

Ft. from W. Line

Location

Rig up

Drilling and Remarks:

sand 2244
2313

TD. 2331

20/10 bbls

RECORD

Cased in., ft.

Sand

Gas

Oil

Total Depth

PRODUCTION

1st 24 hrs. Nat.

1st 24 hrs. after shot

Gas Cu. Ft.

Dry Hole

Abandoned

Date

JUN 10 1923

M. A. BENEAR Scout

492