
Form 51 5M 2-22 8411

Map No. T16 Sec. 22 Twp. 23 R. 10

Well No. 2 Tucker Farm

Both Et. al Company

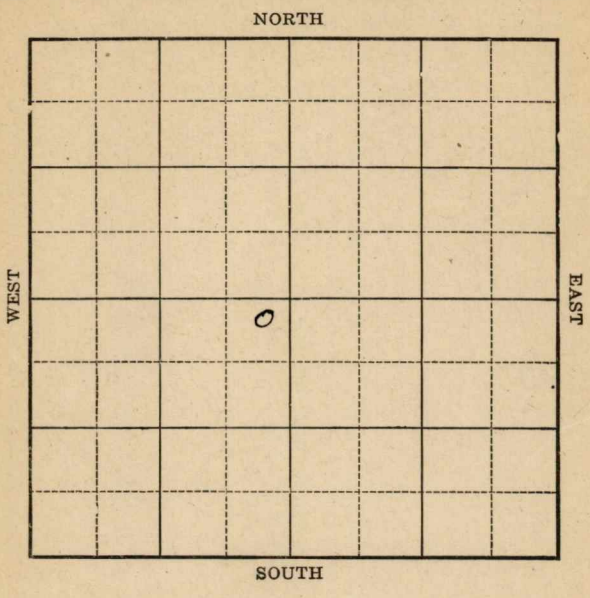

Location

Drilling Remarks:

Rig Up

Drilling Remarks:

RECORD

Cased in. ft.

Sand

Gas

Oil

Total Depth

PRODUCTION

1st 24 hrs. Nat.

1st 24 hrs. after shot

Gas cu. ft.

Dry Hole

Abandoned

Form 252A 5M 4-22 8765

Map No. K Sec. 22 Twp. 23 R. 10

Well No. 2 Tucker Farm


Kirk Ehal. Company

330 Ft. from N. Line

_____ Ft. from S. Line

330 Ft. from E. Line

_____ Ft. from W. Line

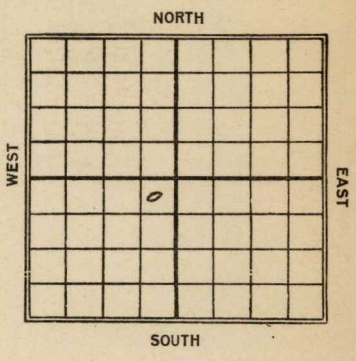

Date 12/23	REPORT
1/24	1260'
1/24	
1/24	DEd 9-2300'

Form 26—1M Bks.—3-23—11959.

Map No. KANSAS 16 Sec. 22 Twp. 23 R. 10

Well No. 2 Tucker

Rath stat Company

Contractor

FIRST REPORT


330 Ft. from N. Line

Ft. from S. Line

330 Ft. from E. Line

Ft. from W. Line

SECTION PLAT

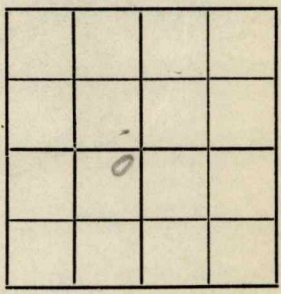

Location

Rig up

Drilling and Remarks:

1260

RECORD

Cased in., ft.

Sand

Gas

Oil

Total Depth

PRODUCTION

1st 24 hrs. Nat.

1st 24 hrs. after shot

Gas Cu. Ft.

Dry Hole

Abandoned

Date

NOV 24 1923

192

M. A. BENEAR

Scout

-3-23—11959.

[redacted] 16 Sec. 22 Twp. 23 R. 10


Well No. 2 - Tucker

Rath etal Company

Contractor

ABANDONED

SECTION PLAT

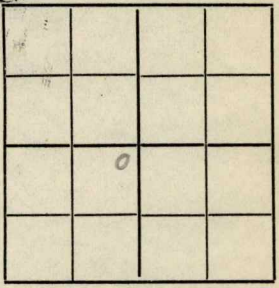

330 Ft. from N. Line

Ft. from S. Line

330 Ft. from E. Line

Ft. from W. Line

Location

Rig up

Drilling and Remarks:

4 0 + 9

2300'

RECORD

Cased in., ft.

Sand

Gas

Oil

Total Depth

PRODUCTION

1st 24 hrs. Nat.

1st 24 hrs. after shot

Gas Cu. Ft.

Dry Hole

Abandoned

Date

JAN 24 1924

192

M. A. BENEAR

Scout