
Form 51—5M—10-26—Mid-West Greenwood

Map No. 55 Sec. 22 Twp. 23 R. 10

Well No. 4 - Tucker Farm

Roth - Faurot - Manhattan Company

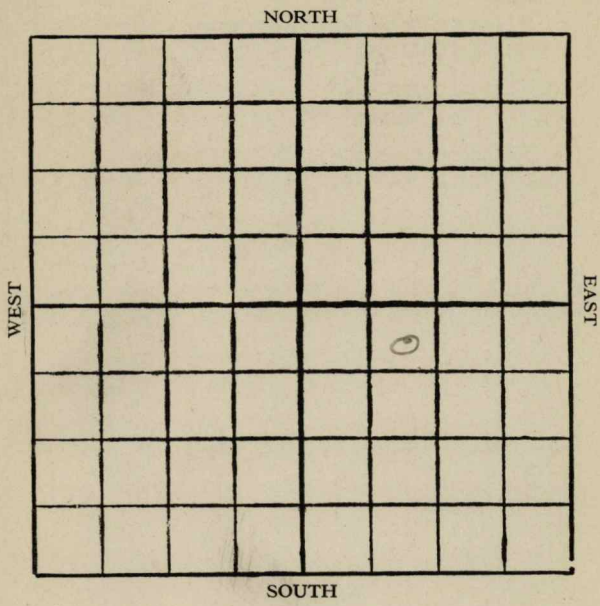

Location	Rig Up
Drilling Remarks	Drilling Remarks
RECORD	PRODUCTION
Cased ..... in. ..... ft.	1st 24 hrs. Nat.
Sand	1st 24 hrs. after shot
Gas	Gas ..... cu. ft.
Oil	Dry Hole
Total Depth	Abandoned

Form 252A—5M—10-26—24951 Greenwood

Map No. K5 Sec. 22 Twp. 23 R. 10

Well No. 4 - Tucker Farm


Roth-Faurot-Manhattan Company

330 Ft. from N. Line

Ft. from S. Line

Ft. from E. Line

990 Ft. from W. Line

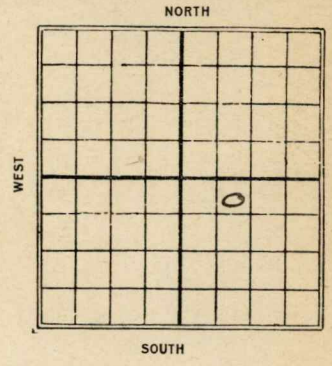

1926

Date	REPORT
12/22	Bldg rig
12/30	same
1927	
1/6	Rigging up
1/13	Spudding
1/19	shut down 375
1/26	S.D. 545
2/3	Drlg - 740
2/10	" 1180
2/17	" 1500
2/24	" 1900
3/2	Broken sand 2198-2252
	pay 2252-61 - T.D. 2271
	in shale - will shoot
3/11	Bkn sd 2198-2252
	pay 2252-2261
	20/20 bbls

Form 26—1M Bks.—3-23—11959. Sherwood

Map No. 16 KANSAS Sec. 22 Twp. 23 R. 10

Well No. 4 Jackson

Both- Faucett & Manhattan Company

Contractor

FIRST REPORTS


330 Ft. from N. Line

Ft. from S. Line

Ft. from E. Line

990 Ft. from W. Line

SECTION PLAT

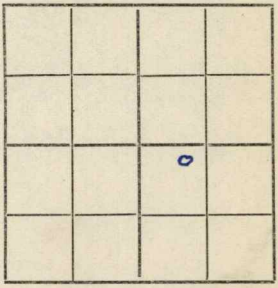

Location

Rig up

Drilling and Remarks:

Slog Rig

RECORD

Cased in., ft.

Sand

Gas

Oil

Total Depth

PRODUCTION

1st 24 hrs. Nat.

1st 24 hrs. after shot

Gas Cu. Ft.

Dry Hole

Abandoned

Date

DEC 22 1926

192

CHAS. L. SHERWOOD

Scout

Form 26—1M Bks.—3-23—11959.

B Sherwood

16 KANSAS

Map No. _____ Sec. 22 Twp. 23 R. 10


Well No. 4 Tucker

Both-Laurel et al Company

_____ Contractor

COMPLETED

SECTION PLAT

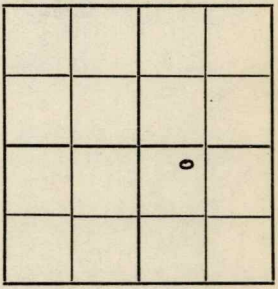

330 Ft. from N. Line

_____ Ft. from S. Line

_____ Ft. from E. Line

990 Ft. from W. Line

Location _____

Rig up _____

Drilling and Remarks:

Broken Sand 2198-2252'

Pay 2252-2261'

Dry 20 Bbls.

RECORD

Cased _____ in., _____ ft.

Sand _____

Gas _____

Oil _____

Total Depth 2271

PRODUCTION

1st 24 hrs. Nat. _____

1st 24 hrs. after shot _____

Gas _____ Cu. Ft.

Dry Hole _____

Abandoned _____

Date

MAR 9 1927

192

CHAS. L. SHERWOOD

Scout