Butler


KANSAS

SECTION 35 TOWNSHIP 27S RANGE 3E

WELL NO. #1 Sparks

COMPANY # T.L. Ferrier

NORTH SW SW SE

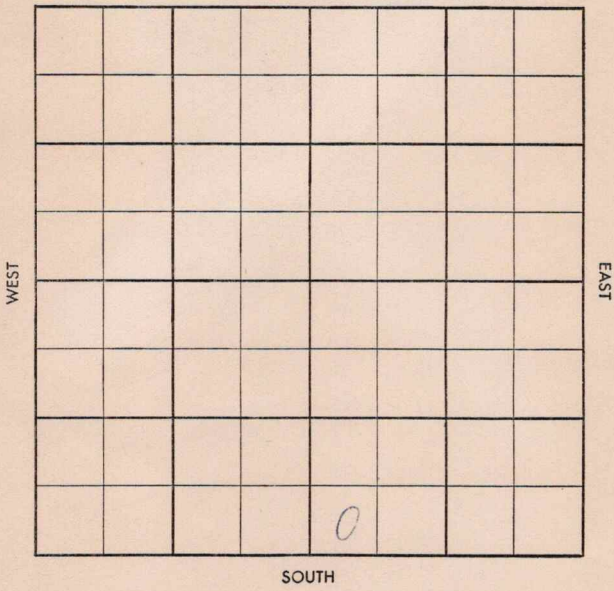

FORM 504-3 SUNRAY

19757

WILDCAT

29

S-513-A

CO. Butler ELEV.

SEC. 35 TWP. 27 RGE. 3E

COMPANY T. L. Ferrier NO. 1

DEC 4 57

FIRST REPORT

FARM Sparks Pure DHM

LOC. SW SW SE

GEOL.

CONTR. White & Ellis #5

POOL Wildcat

SPUD 12/1/57

8" @ 217, WOC

CO. LSE. NO. SEC. TWP. RGE.

29

S-513-A

CO. Butler ELEV. 1249 DF

SEC. 35 TWP. 27 RGE. 3E

COMPANY T. L. Ferrier NO. 1

DEC 11 '57

ABANDONED

FARM Sparks Pure DHM

LOC. SW SW SE

GEOL.

CONTR. White & Ellis #5

POOL Wildcat

SPUD 12/1/57

8" @ 217, WCC

Log tops L 1895
KC 2242 BKC
2435 M 2735
K 2896 S 2977?
Anh 3024 RTD

3058 Log

D&A