

Sedgwick
28 1E

KANSAS

20

Map No. _____ Sec. _____ Twp. _____ R. _____

Well No. _____ Farm _____

4-Yaw
Pickey Oil

Company _____


_____ Ft. from N. Line

990 Ft. from S. Line

_____ Ft. from E. Line

990 Ft. from W. Line

Elev. 1274

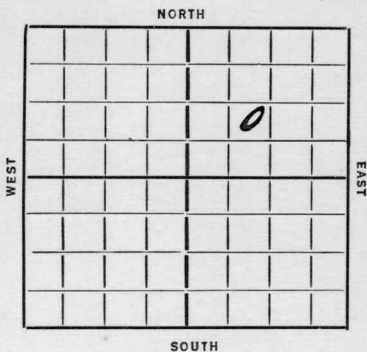

REPORT

~~1936~~

1/8 10" 80
 Top 16 @ 2584
 Sly 2990

1/17 Top Chat 3073
 TD 3079 6" 3079 WOC

1/24 Sho Oil 3081 Sly 3106
 500' OTH

1/31 TD 3114 2000 acid

2/5 Chat 3073
 TD 3114
 2000 acid
 Pot 119 lbs.

COMPLETED

Sedgwick
Form 26-1M Bks. 9-28

KANSAS

Map No. 12 Sec. 20 Twp. 28 R. 1 E

Well No. 4 - yaw

Dickey Oil Company
Contractor

SECTION PLAT

		o	

.....Ft. from N. Line

990 Ft. from S. Line

.....Ft. from E. Line

990 Ft. from W. Line

FIRST REPORT

Location.....

Rig up.....

Drilling and Remarks:

10" - 80

Top KC 2584

duly 2990

RECORD

Cased.....in.,ft.

Sand.....

Gas.....

Oil.....

Total Depth.....

PRODUCTION

1st 24 hrs. Nat.....

1st 24 hrs. after shot.....

Gas.....Cu. Ft.

Dry Hole.....

Abandoned.....

Date

JAN 8 1936 192

ORVAL MANNSCHRECK

Scout

Map No. 12 Sec. 20 Twp. 28 R. 1E

Well No. 4 - Gaus

Dickey Company

Contractor

SECTION PLAT

.....Ft. from N. Line

990 Ft. from S. Line

.....Ft. from E. Line

990 Ft. from W. Line

		0	

COMPLETED

Location.....

Rig up.....

Drilling and Remarks:

2000 acid

Prod. 119 bbls.

RECORD

Cased.....in.,ft.

Sand Chat 3073

Gas.....

Oil.....

Total Depth 3114

PRODUCTION

1st 24 hrs. Nat.....

1st 24 hrs. after shot.....

Gas.....Cu. Ft.

Dry Hole.....

Abandoned.....

Date

FEB 5 1936 192..... ORVAL MANNSCHRECK Scout