
O.W.W.O.

Form 51 5M 8-24 16567

Map No. Kans Sec. 19 Twp. 23 R. 10E

Well No. 1 Race Zimmerman Farm

Ward McGinnis Co. Company

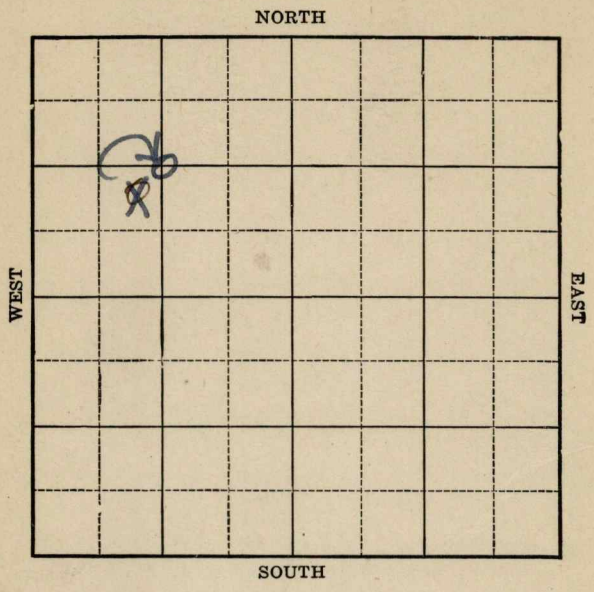

Location

Drilling Remarks

Rig Up

Drilling Remarks

RECORD

Cased in. ft.

Sand

Gas

Oil

Total Depth

PRODUCTION

1st 24 hrs. Nat.

1st. 24 hrs. after shot

Gas cu. ft.

Dry Hole

Abandoned

O.W.W.O.

Form 252A 5M 8-24 16529 Greenwood KANSAS

Map No. Kaw Sec. 19 Twp. 23 R 10 E

Well No. 1 ~~Race~~ Zimmerman Farm

~~Mission~~ Ward McGinnis Company

1320 Ft. from N. Line


~~1020~~ Ft. from S. Line

Ft. from E. Line

1320

~~1020~~ Ft. from W. Line

C/NW/4

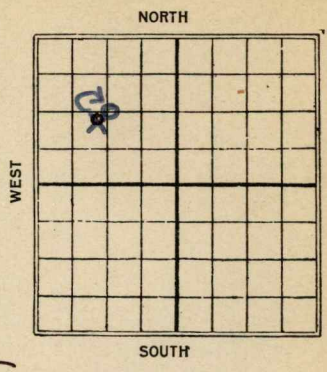

Date	REPORT
	1925
7/31	Rig
8/7	spud.
8/14	850'
8/20	1450'
8/26	1960'
9/	F 2297 1st Oil
	2300-2311 T.D. 2323
	20 gts 15 Bbls
1952	O.W.W.O.
11/26	Bart 2296' OTD 2323'
	CO to DD
1953	
1/23	Spud 12-7-52
	Oil Well
	TD 2323
	Bart 2296'
	TD 2323
	4" @ 2296
	Comp. 25 bopd
	COMPLETED

FORM 275 FOR SALE BY KANSAS BLUE PRINT CO.

County Greenwood State Kansas

Sec. 19 (Blk. / Twp.) 23 (Sur. / Rge.) 10E Map No.

Operator Ward McGinnis

Well No. #1 Farm Zimmerman

Elev. Location C NW/4



1320 Ft. From N Line NW

1320 Ft. From W Line Quarter

1st. Report

Completion JAN 2 3 1953

Remarks

Spudding Date 12-7-52

Drlg. Data Oil well TD 2323

Bart. 2296 TD 2323 4" @ 2296

Comp. 25 bopd

J. G. McGEHEE

FORM 275 FOR SALE BY KANSAS BLUE PRINT CO.

O.W.W.O.


County Greenwood State Kansas

Sec. 19 (Blk. Twp.) 23 (Sur. Rge.) 10E Map No.

Operator Ward McGinnis

Well No. 1 Farm Zimmerman

Elev. Location C NW/4

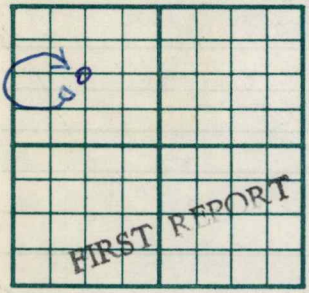

1320 Ft. From N Line NW

1320 Ft. From W Line Quarter

1st. Report NOV 26 1952

O.W.W.O.

Completion

Remarks OWWO

Spudding Date

Drlg. Data

Bart. 2296 OTD 2323 CO to DD

Correct spot

SB

J. G. McGEHEE