Form 51—5M—7-25—19786


Greenwood Co ✓

Map No. Kansas Sec. 20 Twp. 23 R. 10

Well No. 1 Borrer Farm

~~Peck etal~~ Company

Syndicate Oil

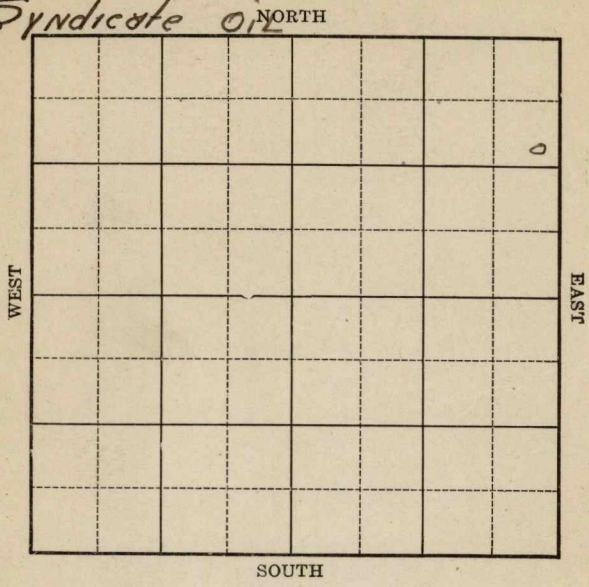

Location

Drilling Remarks

Rig Up

Drilling Remarks

RECORD

Cased in. ft.

Sand

Gas

Oil

Total Depth

PRODUCTION

1st 24 hrs. Nat.

1st 24 hrs. after shot

Gas cu. ft.

Dry Hole

Abandoned

Form 252A—5M—7-25—19684

Greenwood Co

Map No. Kansas Sec. 20 Twp. 23 R 10

Well No. 1 Borrer Farm

~~Peak et al~~ Company


Syndicate Oil

1120 Ft. from N. Line

_____ Ft. from S. Line

200 Ft. from E. Line

_____ Ft. from W. Line

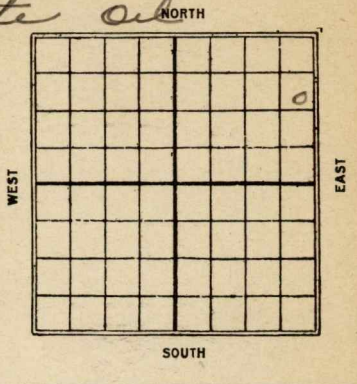

Date 1925	REPORT
11/27	Location
12/3	—
12/10	—
12/17	—
12/23	—
12/31	Rig
1926	
1/8	—
1/14	—
1/20	—
1/27	Rigging up
2/4	Dlg 500'
2/10	" 1200'
2/17	" 1580
2/24	—
3/5	Dlg ~~3330~~ 2330
3/10	" 2350
3/18	Abandoned 2490

Form 26—1M Bks.—3-23—11959. Sherwood Co

K16


Map No. KANSAS Sec. 20 Twp. 22 R. 10

Well No. 1 Bonnor

Recs et al Company

Contractor

SECTION PLAT

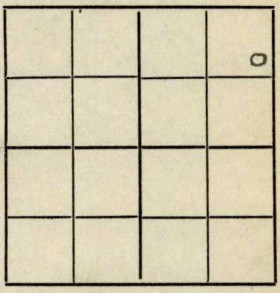

1120 Ft. from N. Line

Ft. from S. Line

200 Ft. from E. Line

Ft. from W. Line

FIRST REPORTS

Location ✓

Rig up

Drilling and Remarks:

RECORD

Cased in., ft.

Sand

Gas

Oil

Total Depth

PRODUCTION

1st 24 hrs. Nat.

1st 24 hrs. after shot

Gas Cu. Ft.

Dry Hole

Abandoned

Date

NOV 27 1925

192

CHAS. L. SHERWOOD

Scout

Form 26—1M Bks.—3-23—11959. Sherwood & Co


Map No. KANSAS Sec. 16 20 Twp. 23 R. 10

Well No. 1 Borron

Syndicate oil Co Company

Contractor

SECTION PLAT

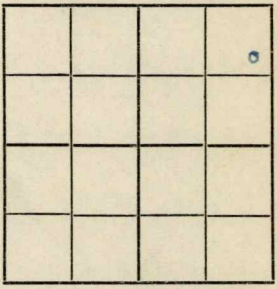

1120 Ft. from N. Line

Ft. from S. Line

300 Ft. from E. Line

Ft. from W. Line

CORRECTION

Location ✓

Rig up

Drilling and Remarks:

Chg ownership to above E.

RECORD

Cased in., ft.

Sand

Gas

Oil

Total Depth

PRODUCTION

1st 24 hrs. Nat.

1st 24 hrs. after shot

Gas Cu. Ft.

Dry Hole

Abandoned

Date

DEC 2 3 1925 192

CHAS. L. SHERWOOD Scout

Form 26—1M Bks.—3-23—11959. C. Sherwood

K16

Map No. KANSAS Sec. 20 Twp. 23 R. 10

Well No. 1 Bonnie

Syndicate Oil Co. Company

Contractor

COMPLETED

1120 Ft. from N. Line


Ft. from S. Line

200 Ft. from E. Line

Ft. from W. Line

ABANDONED

SECTION PLAT

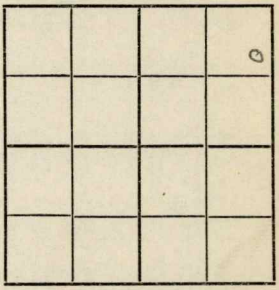

Location

Rig up

Drilling and Remarks:

Top lime 2486

Dry & abd

TD 2490'

A FW

RECORD

Cased in., ft.

Sand

Gas

Oil

Total Depth 2490'

PRODUCTION

1st 24 hrs. Nat.

1st 24 hrs. after shot

Gas Cu. Ft.

Dry Hole ✓

Abandoned ✓

Date

MAR 18 1926

192

CHAS. L. SHERWOOD

Scout