

Map No. KANSAS Sec. 21 Twp. 28 R. 1E

Shell Bit Corp Company

NORTH

WEST

0							

EAST

SOUTH

Location.....

Drilling Remarks

.....

.....

Rig Up.....

Drilling Remarks

.....

.....

RECORD

Cased..... in..... ft.

Sand.....

Gas.....

Oil.....

Total Depth.....

PRODUCTION

1st 24 hrs. Nat.....

1st 24 hrs. after shot.....

Gas..... cu. ft.....

Dry Hole.....

Abandoned.....

Map No. KANSAS Sec. 21 Twp. 28 R. 1E

Well No. 1- Nolan Farm
Shell Pet Corp. Company


_____ Ft. from N. Line

269 Ft. from S. Line

_____ Ft. from E. Line

291 Ft. from W. Line

1929

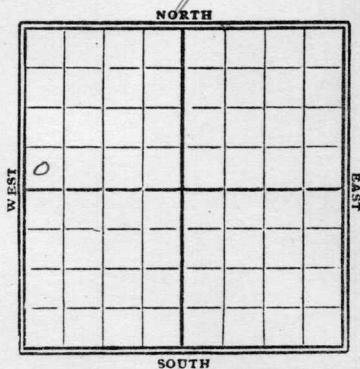

Date


REPORT

5/18	Bldg Rq
5/15	Rign up
5/22	Spud 260'
5/29	Wrlg 910'
6/15	" 1650
6/12	" 1970'
6/19	" 2480
6/26	" 2670'
7/2	" 2850
7/10	Top chat 3081
	Gas 3087
	swab & flow 160 bbls
	T.D. 3105
	Comp.

Map No. KANSAS Sec. 21 Twp. 28 R. 1EWell No. 1 NolanShell Oil Corp. Company

Contractor

SECTION PLAT

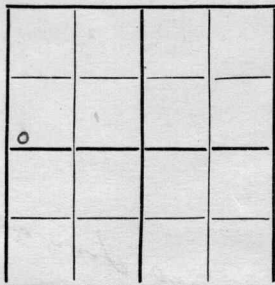

Ft. from N. Line

269 Ft. from S. Line

Ft. from E. Line

291 Ft. from W. Line

FIRST REPORTS

Location

Rig up

Drilling and Remarks:

Building rig

RECORD

Cased in., ft.

Sand

Gas

Oil

Total Depth

PRODUCTION

1st 24 hrs. Nat.

1st 24 hrs. after shot

Gas Cu. Ft.

Dry Hole

Abandoned

Date

MAY 8 1929S. J. LEWIS Scout

Map No. 12 **KANSAS** Sec. 21 Twp. 28 R. 1E

Well No. 1 Nolan

Shell Pet. Corp. Company

Contractor

SECTION PLAT

0			

_____ Ft. from N. Line

269 Ft. from S. Line

_____ Ft. from E. Line

291 Ft. from W. Line

COMPLETED

Location _____

Rig up _____

Drilling and Remarks:

Top Chat 3081
Gas 3087

Swabby / Lined
160 ft. ls.

RECORD

Cased _____ in., _____ ft.

Sand _____

Gas _____

Oil _____

Total Depth 3105

PRODUCTION

1st 24 hrs. Nat. _____

1st 24 hrs. after shot _____

Gas _____ Cu. Ft.

Dry Hole _____

Abandoned _____

Date

JUL 10 1929

19

S. J. LEWIS

Scout