
Form 51—5M—7-25—19786

Greenwood Co ✓

Map No. Kansas Sec. 22 Twp. 23 R. 10

Well No. 34 Scott Farm

Roth & Faurot Company

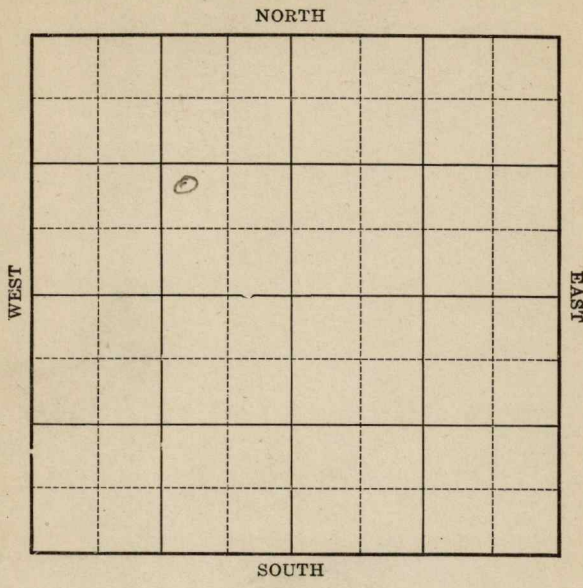

Location

Drilling Remarks

Rig Up

Drilling Remarks

RECORD

Cased in. ft.

Sand

Gas

Oil

Total Depth

PRODUCTION

1st 24 hrs. Nat.

1st 24 hrs. after shot

Gas cu. ft.

Dry Hole


Abandoned

Form 252A—5M—7-25—19684 Greenwood Co

Map No. Kansas Sec. 22 Twp. 23 R 10

Well No. 3 Scott Farm

Roth & Fawcett Company

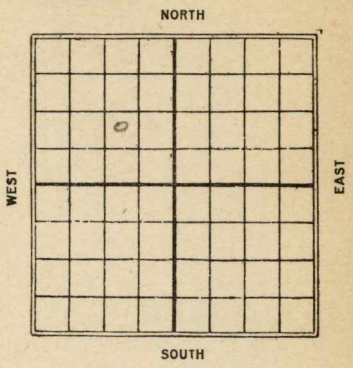

_____ Ft. from N. Line

762 Ft. from S. Line

762 Ft. from E. Line

_____ Ft. from W. Line

Date 1925	REPORT
11/19	Location
11/24	Dsly 1265'
12/3	S/O 1460'
12/10	Dsly 1590'
12/17	Dry sand 2107-10' Dsly 4142' in shale
12/23	S. D. 2300'
12/31	Dry sand 2107-10 - D & A. 2263' T. Lime 2263

Form 26—1M Bks.—3-23—11959. Sherwood Co

Map No. K16 KANSAS Sec. 22 Twp. 23 R. 10

Well No. 3A Scott

Roth & Thurst Company

Contractor

FIRST REPORTS


Ft. from N. Line

762 Ft. from S. Line

762 Ft. from E. Line

Ft. from W. Line

SECTION PLAT

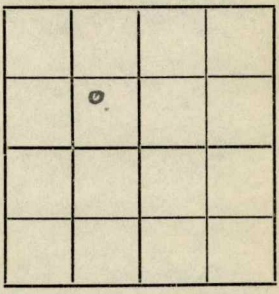

Location ✓

Rig up

Drilling and Remarks:

RECORD

Cased in., ft.

Sand

Gas

Oil

Total Depth

PRODUCTION

1st 24 hrs. Nat.

1st 24 hrs. after shot

Gas Cu. Ft.

Dry Hole

Abandoned

Date

NOV 19 1925

192

CHAS. L. SHERWOOD

Scout

Form 26—1M Bks.—3-23—11959. Sherwood Co

Map No. 16 KANSAS Sec. 22 Twp. 23 R. 10

Well No. 3 A Scott

Roth & Zaruba Company

Contractor

ABANDONED

762 Ft. from N. Line


762 Ft. from S. Line

Ft. from E. Line

Ft. from W. Line

COMPLETED

SECTION PLAT

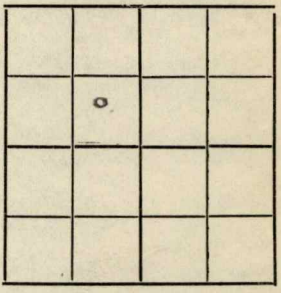

Location

Rig up

Drilling and Remarks:

Top Lime
2263'
Dry & Shut
T.D. 2263'

RECORD

Cased in., ft.

Sand Dry 1107-10'

Gas

Oil

Total Depth 2263'

PRODUCTION

1st 24 hrs. Nat.

1st 24 hrs. after shot

Gas Cu. Ft.

Dry Hole ✓

Abandoned

Date

DEC 3 1 1925

192

CHAS. L. SHERWOOD

Scout