
DX 78-1

Sedgwick KANSAS

Section 21 Township 28 Range 1E

Well No. 5 Knowland (Nolan)

Company ~~Stelbar~~

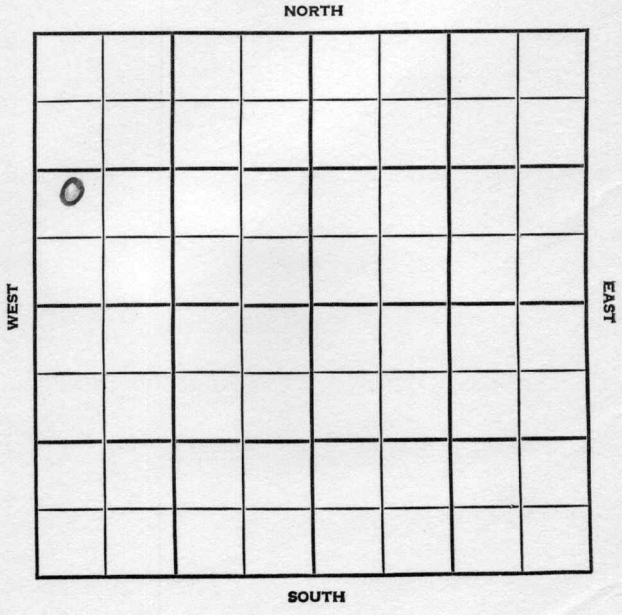

Sedgwick KANSAS

SEC.	TWP.	R.
21	28	1E

WELL NO.
5 Knowland FARM

COMPANY
Stelbar

CONTRACTOR
Bedell & Cat
Robbins


940 Ft. from N. Line

_____ Ft. from S. Line

_____ Ft. from E. Line

_____ Ft. from W. Line

NW SW NW

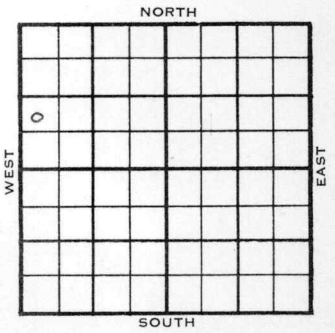

1955	ELEVATION 1276' REPORT
6/29	Comm 6-25-55 Drlg 1360'
8/17	5½" @3086 CO to 3090 500 A S/8 bo 35 bw 11 hr. S/7 bo 32 bw 8 hr. Comp: 25 bopd 50 bw. M. Dolo: 3073, 1797, TD: 3090 COMPLETED

DX-78

FORM 513 REV. SUNRAY

County Sedgwick Elev.

Sec. 21 Twp. 28 Rge. 1E

Company Stelbar

Farm Name Knowland No. 5

TOPS	DEPTH	LOG	DATUM
Anh.			
Tp.			
H.			
Tr.			
Dg.			
B.L.			
L.			
K.C.			
B.K.C.			
Ce.			
C.			
M.			
M.			
K.			
Mz.			
Mq.			
V.			
S.			
S.			
A			
R.			
P€.			
G.			
T.D.			

Loc. in Sec. NW SW NW 940' SL

Geol.

Contr. Bedell & Cat

Pool Robbins



Date Comm. 6-25-55

drlg. 1360

Co. Lse. No. Sec. T. R.

FORM 513 REV. SUNRAY

County Sedgwick Elev. 1276

Sec. 21 Twp. 28 Rge. 1E

Company Stelbar Oil

Farm Name Knowland No. 5

TOPS	DEPTH	LOG	DATUM
Anh.			
T.p.			
H.			
Tr.			
Dg.			
B.L.			
L.			
K.C.			
B.K.C.			
Ce.			
C.			
M. Polo	3073		1797
M.			
K.			
Mz.			
Mq.			
V.			
S.			
Si.			
A			
R.			
P€.			
G.			
T.D.	3090		

Loc. in Sec. NW SW NW

Geol.

Contr. Bedell & Catt

Pool Robbins

COMPLETE

Date Comm. 6-25-55 AUG 17 1955

8 5/8" @ 84 5½" @ 3086 CO to 3090

500 A S/ 8 bo 35 bw 11 hr.

S/ 7 bo 32 bw 8 hr.

Comp. 25 bopd 50 bw

Co. Lse. No. Sec. T. R.