

KANSAS

Map No. _____ Sec. 4 Twp. 34 R. 3W

Well No. 1-Werneke Farm

Sam Jarvis et al Company

NORTH

WEST

EAST

SOUTH

Location

Drilling Remarks

Rig Up

Drilling Remarks

RECORD

Cased in. ft.

Sand

Gas

Oil

Total Depth

PRODUCTION

1st 24 hrs. Nat.

1st 24 hrs. after shot

Gas cu. ft.

Dry Hole

Abandoned


KANSAS
 Map No. _____ Sec. 4 Twp. 34 R. 3w
 Well No. 1-Werneke Farm
Sam Jarvis et al Company

NORTH

Ft. from N. Line

300 Ft. from S. Line300 Ft. from E. Line

Ft. from W. Line

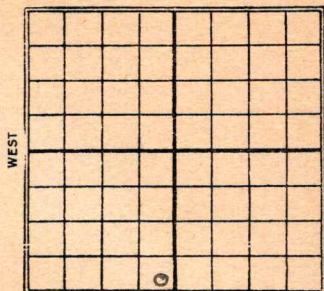

SOUTH

1927

Date

REPORT

2/16	Location
2/23	Timbers
3/2	Rig
3/9	Rigging up
3/16	
3/23	Part rigged up-S.D.
3/30	
4/6	
4/13	Running water line
4/20	S.D. for high water
4/27	
5/4	
5/11	
5/25	Rigged up S.D.
6/1	
6/8	
6/15	Getting ready to start up again
6/22	Drill 510
6/29	" 1050
7/6	" 1485
7/13	" 1690
7/20	" 2400
7/27	" 2840

8/3 - Drlg 3250

8/10 - " 3385

8/17 - T.D. 3400 - U.P. 8"

8/24 - T.D. 3580 - S.D. for finances

8/31 _____

9/7 _____

9/14 - T.D. 3585 - Shut down.

9/20 _____

9/28 _____

10/5 _____

10/12 _____

10/19 _____

10/26 _____

11/2 _____

11/9 _____

11/16 _____

11/22 _____

11/29 _____

12/7 - Drlg 3625.

12/14 - " 3700

12/21 - Set 6" - 3705 - hard dry lime -

show oil exhausted -

drilling 3709 -

12/28 - T.D. 4207 - Shut down -

1928

1/4 - S.D. 4207

1/11 _____ 4/25 _____

1/18 _____ 5/2 _____

1/25 _____ 5/9 _____

1/31 _____ 5/16 _____

2/15 _____ 5/23 _____

2/22 _____ 5/31 _____

2/29 _____ 6/6 _____

3/7 _____ 6/13 _____

3/14 _____ 6/20 _____

3/21 _____ 6/27 _____

3/28 _____ 7/3 _____

4/4 _____ 7/11 - T.D. 4207 - Rign up

4/11 _____ 7/18 Drlg 4250 - hole casing -

4/18 _____ 7/25 - Shut down -

8/1 - Starting

8/7 - T.D. 4250

U.P. 6"

8/15 - S.D. 4250

8/22 Drlg 4250


Map No. **KANSAS** Sec. 4 Twp. 34 R. 3^W

.....Ft. from N. Line

300 Ft. from S. Line

300 Ft. from E. Line

.....Ft. from W. Line

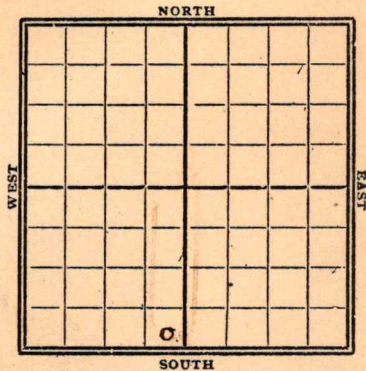

1928

Date

REPORT

8/22	Drill 4250' $\frac{1}{2}$ " 6"
9/5	Chat 4252 Drill.
9/12	Drill - 4291
9/19	" 4457'
9/24	Top Wilcox 4675-77
	no show
9/26	S.D. 4679 for boiler repair
10/3	HFV - 4683 - 85' TD - SD
10/10	
10/17	T.D. 4686 $\frac{1}{2}$ SLM
	Shut down
10/24	Dry & Abandoned
	T.D. 4686 $\frac{1}{2}$ ft.

Donner
nomap
 Map No **KANSAS** Sec. 4 Twp. 34 R. 24

Well No. 1 Verneke

San Jarvis & Co. Company

Contractor

SECTION PLAT

_____ Ft. from N. Line

300 Ft. from S. Line

300 Ft. from E. Line

_____ Ft. from W. Line

FIRST REPORTS

Location ✓

Rig up _____

Drilling and Remarks:

RECORD

Cased _____ in., _____ ft.

Sand _____

Gas _____

Oil _____

Total Depth _____

PRODUCTION

1st 24 hrs. Nat. _____

1st 24 hrs. after shot _____

Gas _____ Cu. Ft.

Dry Hole _____

Abandoned _____

Date

FEB 16 1927

S. J. LEWIS

Scout

MAP No. KANSAS SEC. 4 TWP. 34 R. 3W

WELL No. 1 Verneke

Sam Jarvis & Co. COMPANY

CONTRACTOR

SECTION PLAT

_____ FT. FROM N. LINE

300 FT. FROM S. LINE

300 FT. FROM E. LINE

_____ FT. FROM W. LINE

ABANDONED

LOCATION _____

RIG UP _____

DRILLING AND REMARKS:

DYA

RECORD

CASED _____ IN. _____ FT.

SAND _____

GAS _____

OIL _____

TOTAL DEPTH 4686 1/2

PRODUCTION

1ST 24 HRS. NAT. _____

1ST 24 HRS. AFTER SHOT _____

GAS _____ CU. FT.

DRY HOLE _____

ABANDONED _____

DATE

OCT 24 1928

192

S. J. LEWIS

SCOUT