
Form 51 5M 11-23 13896

Map No. Kan Sec. 22 Twp. 23 R. 10

Well No. 3 Tucker Farm

Roth Taurol & Missouri Company

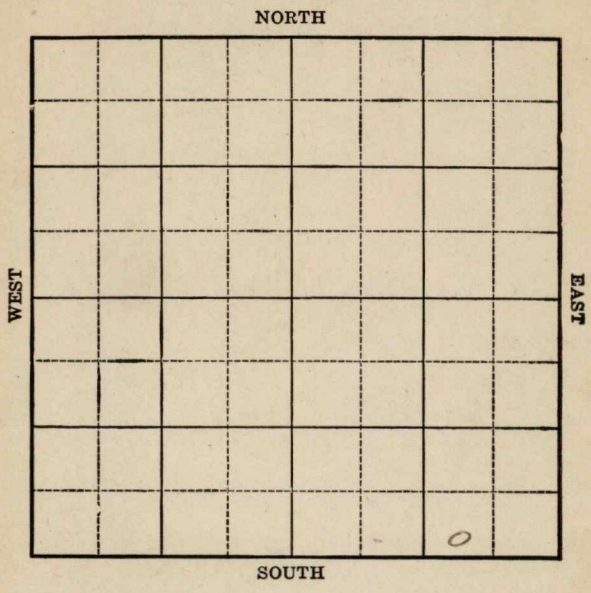

Location _____

Drilling Remarks:

Rig Up _____

Drilling Remarks:

RECORD

Cased _____ in. _____ ft.

Sand _____

Gas _____

Oil _____

Total Depth _____

PRODUCTION

1st 24 hrs. Nat. _____

1st 24 hrs. after shot _____

Gas _____ cu. ft.

Dry Hole _____


Abandoned _____

Form 252A 5M 8-24 16529

Map No. Kaw Sec. 22 Twp. 23 R 10

Well No. 3 Tusker Farm

Roth & Mission Company

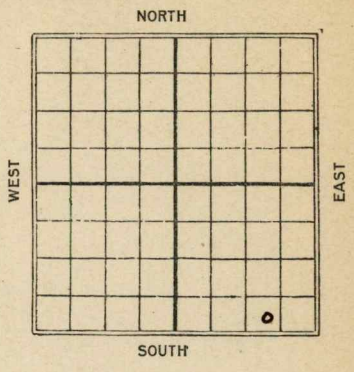

____ Ft. from N. Line

264 Ft. from S. Line

792 Ft. from E. Line

____ Ft. from W. Line

C

Date 1935	REPORT
7/3	Rig up
7/10	660
7/17	750
7/24	1405'
7/31	No Vs
8/7	Dry & Abandoned T.D. 2343'

Form 26—1M Bks.—3-23—11959.

Map No. 16 Kern Sec. 22 Twp. 23 R. 10

Well No. 3 Lucke W

Roth & Mission Oil Co. Company

Contractor

FIRST REPORTS


Ft. from N. Line

264 Ft. from S. Line

792 Ft. from E. Line

Ft. from W. Line

SECTION PLAT

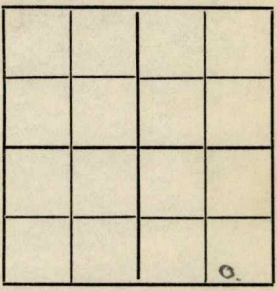

Location

Rig up

Drilling and Remarks:

Rigging up

RECORD

Cased in., ft.

Sand

Gas

Oil

Total Depth

PRODUCTION

1st 24 hrs. Nat.

1st 24 hrs. after shot

Gas Cu. Ft.

Dry Hole

Abandoned

Date

JUL 3 1925

192

CHAS. L. SHERWOOD

Scout

Form 26—1M Bks.—3-23—11959.

Map No. 16 Sec. 22 Twp. 13 R. 10

Well No. 3 Jacobs

Roth & Mission Oil Co. Company

Contractor

COMPLETED

Ft. from N. Line


264 Ft. from S. Line

792 Ft. from E. Line

Ft. from W. Line

ABANDONED

SECTION PLAT

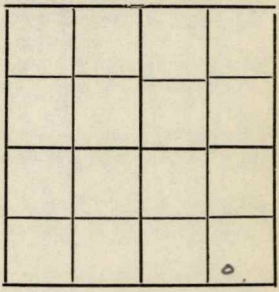

Location

Rig up

Drilling and Remarks:

Dry & Abd

T.D. 2343'

RECORD

Cased in., ft.

Sand

Gas

Oil

Total Depth 2343'

PRODUCTION

1st 24 hrs. Nat.

1st 24 hrs. after shot

Gas Cu. Ft.

Dry Hole ✓

Abandoned

Date

AUG 7 1925

192

CHAS. L. SHERWOOD

Scout