
Form 51 5M 7-22 9573

Map No. _____ Sec. 23 Twp. 23 R. 10

Well No. 3 Allen Farm

Mid Kansas Company

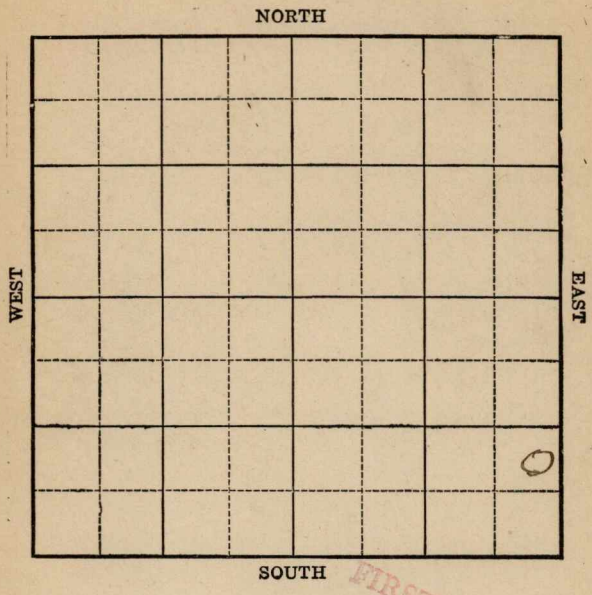

FIRST REPORT

Location _____

Drilling Remarks:

Rig up _____

Drilling Remarks:

RECORD

Cased _____ in. _____ ft.

Sand _____

Gas _____

Oil _____

Total Depth _____

PRODUCTION

1st 24 hrs Nat. _____

1st 24 hrs. after shot _____

Gas _____ cu. ft.

Dry Hole _____

Abandoned _____

Form 252A 5M 8-21 PALACE–TULSA 6835

Map No. _____ Sec. 23 Twp. 23 R. 10

Well No. 3 Allen Farm


Mid-Kansas Company

_____ Ft. from N. Line

990 Ft. from S. Line

330 Ft. from E. Line

_____ Ft. from W. Line

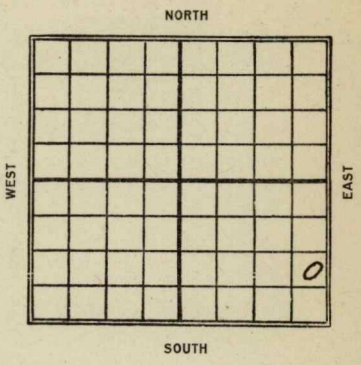

Date 1923	REPORT
1/6	Rig & tools.
2/24	Sand 2024-2101-Shot 100 qts. 100 Bbls.

Form 26—1M—4-19—Mid-West

Map No. KANSAS 16 Sec. 23 Twp. 23 R. 10


Well No. 3 Allen

Mid-Kansas Company

Contractor

FIRST REPORT

SECTION PLAT

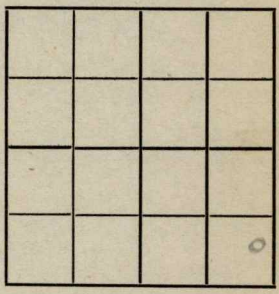

990 Ft. from N. Line

Ft. from S. Line

330 Ft. from E. Line

Ft. from W. Line

Location

Rig up

Drilling and Remarks:

Rig & tools

RECORD

Cased in., ft.

Sand

Gas

Oil

Total Depth

PRODUCTION

1st 24 hrs. Nat.

1st 24 hrs. after shot

Gas Cu. Ft.

Dry Hole

Abandoned

Date

JAN 6 1923

191

M. A. BENEAR

Scout

Form 26—1M—4-19—Mid-West

Map No. KANSAS Sec. 23 Twp. 23 R. 10


Well No. 3 Allen

Mid Kansas Company

Contractor

COMPLETED

SECTION PLAT

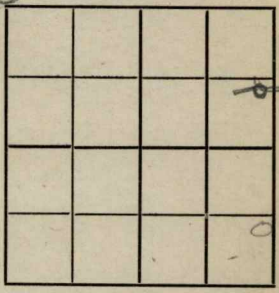

Ft. from N. Line

990 Ft. from S. Line

330 Ft. from E. Line

Ft. from W. Line

Location

Rig up

Drilling and Remarks:

shot 100 qts

RECORD

Cased in., ft.

Sand

Gas

Oil 2024-2101

Total Depth 2101

PRODUCTION

1st 24 hrs. Nat.

1st 24 hrs. after shot 100

Gas Cu. Ft.

Dry Hole

Abandoned

Date

FEB 24 1923

191

M. A. BENEAR

Scout