
Form 51 5M 7-22 9573

Map No. _____ Sec. 23 Twp. 23 R. 10

Well No. 4 Allen Farm

Mid-Kansas Company

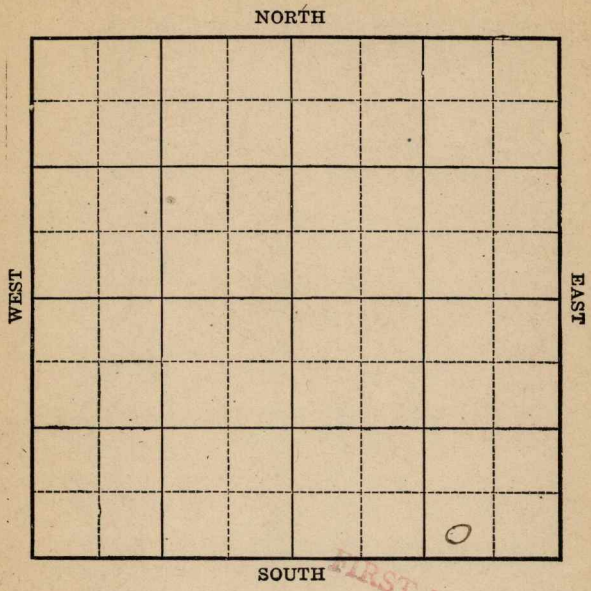

FIRST REPORT

Location _____

Drilling Remarks:

Rig up _____

Drilling Remarks:

RECORD

Cased _____ in. _____ ft.

Sand _____

Gas _____

Oil _____

Total Depth _____

PRODUCTION

1st 24 hrs Nat. _____

1st 24 hrs. after shot _____

Gas _____ cu. ft.

Dry Hole _____

Abandoned _____

Form 252A 5M 8-21 PALACE-TULSA 6835

Map No. _____ Sec. 23 Twp. 23 R. 10

Well No. 4 Allen Farm


Mid-Kansas Company

_____ Ft. from N. Line

330 Ft. from S. Line

990 Ft. from E. Line

_____ Ft. from W. Line

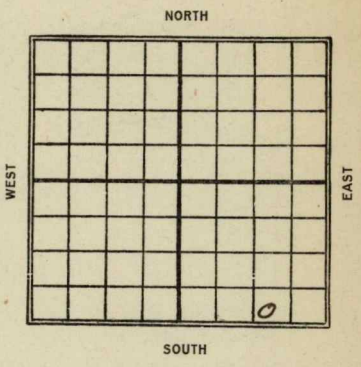

Date 1923	REPORT
1/6	Rig.
8/4	
11/3	2061-2106- Shot 170 qts/40 Bbls

Form 26—1M—4-19—Mid-West

Map No. KANSAS 16 Sec. 23 Twp. 23 R. 10


Well No. 4 Allen

Mid-Kansas Company

Contractor

FIRST REPORT

SECTION PLAT

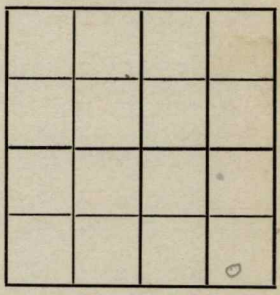

330 Ft. from N. Line

Ft. from S. Line

990 Ft. from E. Line

Ft. from W. Line

Location

Rig up 4-6

Drilling and Remarks:

RECORD

Cased in., ft.

Sand

Gas

Oil

Total Depth

PRODUCTION

1st 24 hrs. Nat.

1st 24 hrs. after shot

Gas Cu. Ft.

Dry Hole

Abandoned

Date

JAN 6 1923

191

M. A. BENEAR

Scout

Form 26—1M Bks.—3-23—11959.

Map No. KANSAS 16 Sec. 23 Twp. 23 R. 10


Well No. 4 Allen

Mid-Kansas Company

Contractor

COMPLETED

SECTION PLAT

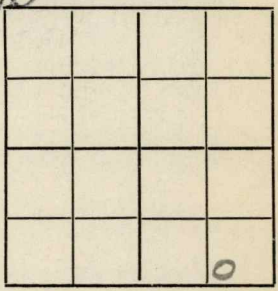

330 Ft. from N. Line

Ft. from S. Line

990 Ft. from E. Line

Ft. from W. Line

Location

Rig up

Drilling and Remarks:

sand 2061-2106

120/40 bbls

RECORD

Cased in., ft.

Sand

Gas

Oil

Total Depth

PRODUCTION

1st 24 hrs. Nat.

1st 24 hrs. after shot

Gas Cu. Ft.

Dry Hole

Abandoned

Date

NOV 3 1923 192

M. A. BENEAR Scout