


Map No. Sedgwick 23 Sec. 28 Twp. 1E R. 1E

Well No. Carlton Farm

Mission Oil & Gas Company

NORTH

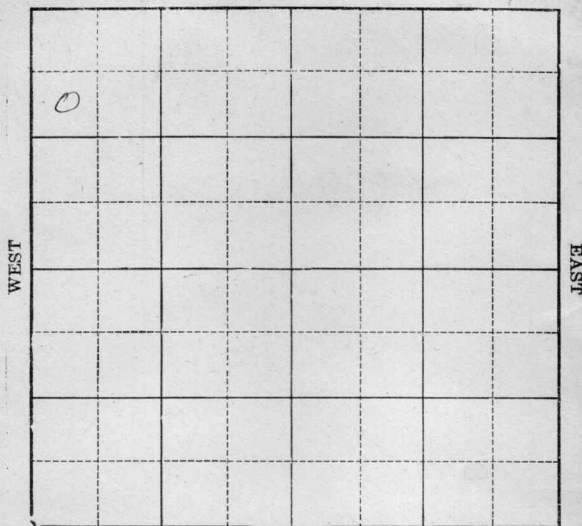

SOUTH

Location _____

Drilling Remarks _____

Rig Up _____

Drilling Remarks _____

RECORD

Cased _____ in. _____ ft.

Sand _____

Gas _____

Oil _____

Total Depth _____

PRODUCTION

1st 24 hrs. Nat. _____

1st 24 hrs. after shot _____


Gas _____ cu. ft.

Dry Hole _____

Abandoned _____

Sedgwick
 Map No. KANSAS Sec. 23 Twp. 28 R. 1E
 Well No. 1 - Carlton Farm
Mission Oil and Company

NORTH

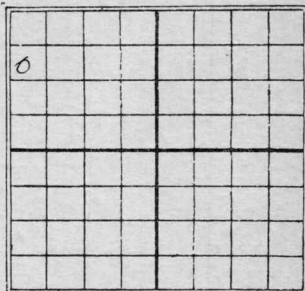

990 Ft. from N. Line

_____ Ft. from S. Line

_____ Ft. from E. Line

330 Ft. from W. Line

1930

SOUTH

Date	REPORT
8/6	Bldg rug
8/13	
8/20	Ryn up.
8/27	
9/3	Spud 140'
9/10	Drly 645'
9/17	" 740'
9/24	" 1050'
10/1	" 1078'
	12" - 1062'
10/8	Drly 1520'
10/15	2 1/2" 10" - 1685'
10/22	Drly 1880'
10/29	" 2300'
11/5	8" - 2318' T.D. 2602
	2 1/2" 8"
11/12	8" - 2563' Drly 2732'
11/19	Drly 2885'
11/25	Tap Shot 3028'
	6" - 3035'
	Drly 3175'

12/2 Top Wilcox 3442
HFW at 3454
T.D. 3460
Dry & Abandon

Map No. KANSAS Sec. 23 Twp. 28 R. 15

Well No. 1 Carlton

Mission Oil & Gas Company

Contractor

SECTION PLAT



990 Ft. from N. Line

_____ Ft. from S. Line

_____ Ft. from E. Line

330 Ft. from W. Line

FIRST REPORTS

Location _____

Rig up _____

Drilling and Remarks:

Building rig

RECORD

Cased _____ in., _____ ft.

Sand _____

Gas _____

Oil _____

Total Depth _____

PRODUCTION

1st 24 hrs. Nat. _____

1st 24 hrs. after shot _____

Gas _____ Cu. Ft.

Dry Hole _____

Abandoned _____

Date

AUG 6 1930

19

S. J. LEWIS Scout

Map No. 12 KANSAS Sec. 23 Twp. 28 R. 15

Well No. 1 Carlton

Mission Oil & Gas Co. Company

Contractor

SECTION PLAT

0			

990 Ft. from N. Line

..... Ft. from S. Line

..... Ft. from E. Line

330 Ft. from W. Line

ABANDONED

RECORD

Location.....

Cased.....in.,ft.

Rig up.....

Sand.....

Drilling and Remarks:

Gas.....

Oil.....

Total Depth 3460

PRODUCTION

1st 24 hrs. Nat.....

1st 24 hrs. after shot.....

Gas.....Cu. Ft.

Dry Hole.....

Abandoned.....

Date

DEC 3 1930 192 S. J. LEWIS Scout