
Form 51 5M 7-22 9573

Map No. _____ Sec. 23 Twp. 23 R. 10

Well No. 11 Allen Farm

Mid-Kansas Company

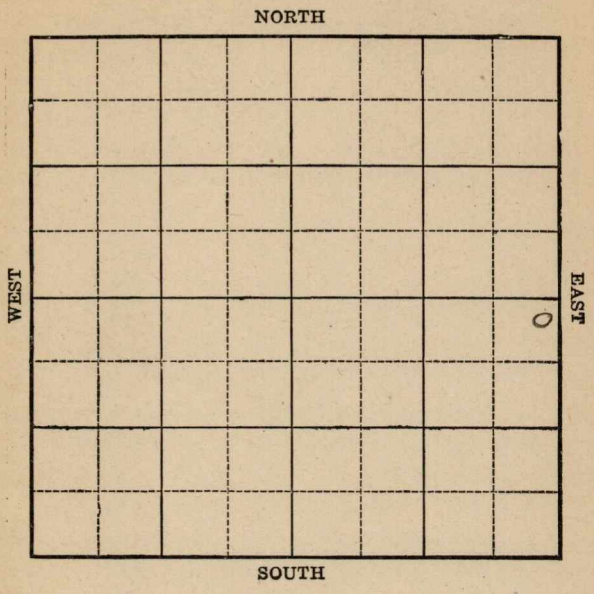

Location _____

Drilling Remarks:

Rig up _____

Drilling Remarks:

RECORD

Cased _____ in. _____ ft.

Sand _____

Gas _____

Oil _____

Total Depth _____

PRODUCTION

1st 24 hrs Nat. _____

1st 24 hrs. after shot _____

Gas _____ cu. ft.

Dry Hole _____

Abandoned _____

Form 252A 8M-11-20 PALACE-TULSA 4617

Map No. Sec. 23 Twp. 23 R. ~~13~~ 10

Well No. 11 Allen Farm


Mid-Kansas Company

330 Ft. from N. Line

Ft. from S. Line

330 Ft. from E. Line

Ft. from W. Line

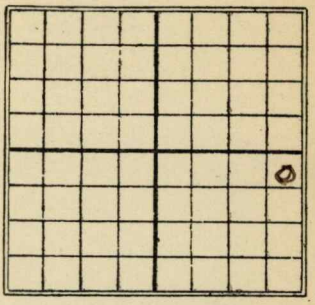

Date 1923	REPORT
3/2	R.O.S.
6/10	J.S. 2054- Ray 2066- 2123- Shot 120 qts 200 Bbls.

Form 26—1M—4-19—Mid-West

Map No. KANSAS Sec. 23 Twp. 23 R. 10

Well No. 11 allen

Mid-Kansas Company

Contractor

FIRST REPORT


330 Ft. from N. Line

Ft. from S. Line

330 Ft. from E. Line

Ft. from W. Line

SECTION PLAT

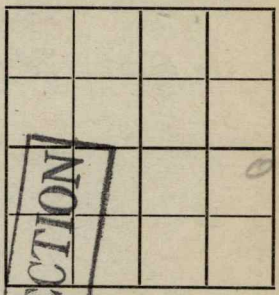

Location

Rig up

Drilling and Remarks:

R.O.Is.

RECORD

Cased in., ft.

Sand

Gas

Oil

Total Depth

PRODUCTION

1st 24 hrs. Nat.

1st 24 hrs. after shot

Gas Cu. Ft.

Dry Hole

Abandoned

RETURNED FOR CORRECTION

Date

MAR 2 1923

191

M. A. BENEAR

Scout

Form 26—1M Bks.—3-23—11959.

Map No. KANSAS 16 Sec. 23 Twp. 23 R. 10

Well No. 11 Allen

Mid-Kansas Company

Contractor

COMPLETED


330 Ft. from N. Line

Ft. from S. Line

330 Ft. from E. Line

Ft. from W. Line

SECTION PLAT

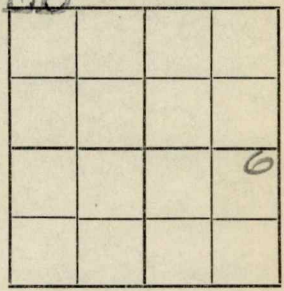

Location

Rig up

Drilling and Remarks:

Top sand 2054
pay 2066
2123
120/200 bbls

RECORD

Cased in., ft.

Sand

Gas

Oil

Total Depth

PRODUCTION

1st 24 hrs. Nat.

1st 24 hrs. after shot

Gas Cu. Ft.

Dry Hole

Abandoned

Date

JUN 10 1923

192

M. A. BENEAR

Scout

Doesn't this belong in 23-10 instead of 23-13?

Should be 23-23/10

M.L.

Returned	
Cards	
Tracing	
J. S. C. map	
Frantz map	
Moody map	
Frantz plat book	
Moody plat book	