

Map No. _____ Sec. 23 Twp. 23 R. 10

Well No. 12 Allen Farm
Mid - Kansas Company

NORTH

WEST

EAST

SOUTH

Location _____

Drilling Remarks:

Rig up _____

Drilling Remarks:

RECORD

Cased _____ in. _____ ft.

Sand _____

Gas _____

Oil _____

Total Depth_____

PRODUCTION

1st 24 hrs Nat. _____

1st 24 hrs. after shot_____

Gas _____ cu. ft.


Dry Hole_____

Abandoned _____

Map No. _____ Sec. 23 Twp. 23 R. 10

Well No. 12 Allen Farm _____
Mid-Kansas Company _____

_____ Ft. from N. Line
330 Ft. from S. Line
_____ Ft. from E. Line
1168
480 Ft. from W. Line

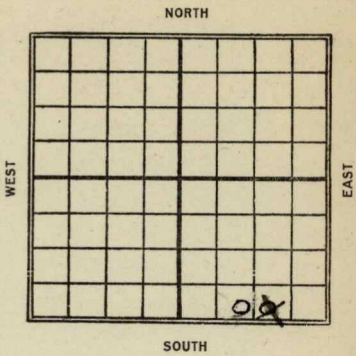

Date	REPORT
1923	
3/2	R.O.S.
8/9	land rr 90-2310 shot
	60 qts made 50 bbls

Map No. **KANSAS** ¹⁶ Sec. ²³ Twp. ²³ R. ¹⁰Well No. ^{12 Allen}^{Mid-Kansas} Company

Contractor

FIRST REPORT

SECTION PLAT

Ft. from N. Line

³³⁰ Ft. from S. Line

Ft. from E. Line

⁹⁸⁰ Ft. from W. Line

Location

Rig up

Drilling and Remarks:

^{R.O.G.}

RECORD

Cased _____ in., _____ ft.

Sand _____

Gas _____

Oil _____

Total Depth _____

PRODUCTION

1st 24 hrs. Nat. _____

1st 24 hrs. after shot _____

Gas _____ Cu. Ft.

Dry Hole _____

Abandoned _____

Date

MAR 2 1923

M. A. BENEAR

191

Scout

Map No. 16 Kans Sec. 23 Twp. 23 R. 10Well No. 12 AllenMid-Kansas Company

Contractor

Completed

SECTION PLAT

Ft. from N. Line

330 Ft. from S. Line1168 Ft. from E. Line1168 Ft. from W. Line

Location

Rig up

Drilling and Remarks:

sand 2290-2310600/50 lbs

RECORD

Cased in., ft.

Sand

Gas

Oil

Total Depth

PRODUCTION

1st 24 hrs. Nat.

1st 24 hrs. after shot

Gas Cu. Ft.


Dry Hole

Abandoned

Date

8/4 1923Scout

Is this in SE 40
or SW 40. Previously
reported 330' from S
+ 980' from W.

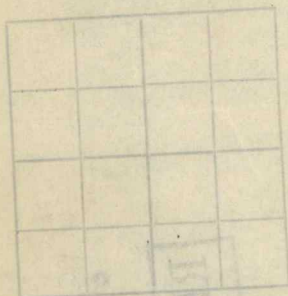

Pl. from N. Line

Pl. from S. Line

Pl. from E. Line

Pl. from W. Line

RECORD

Case 11
Sand
Gas
Oil
Total Depth

Location

Rig up

Drilling and Remarks:

PRODUCTION

1st 24 hrs. 23.1
1st 24 hrs. after shot
Cu. Ft.
Dry Hole
Abandoned

Returned Jim
Cards SPB
Tracing Jim
J. S. C. map Jim
Frantz map SPB
Moody map Jim
Frantz plat book
Moody plat book