

KANSAS

FORM 51 5M 4-41 PETROL


Barton

Section 31 Township 20 Range 13-W

Well No. #2 Asher

Company Atlantic et al

NORTH Hiss Pool

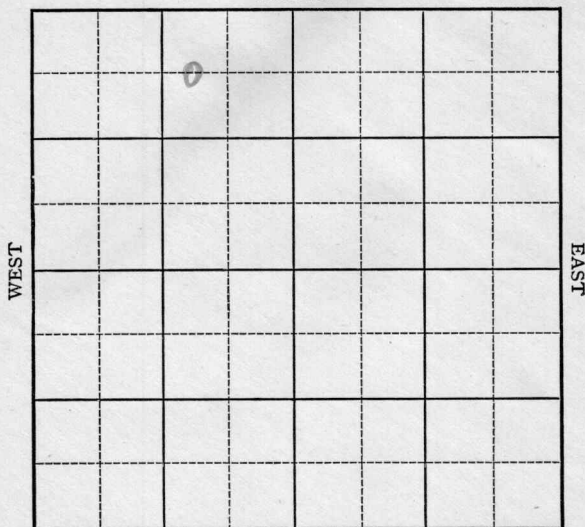

SOUTH

COMPLETED

Map No. 82 Sec. 31 Twp. 20 R. 13WWell No. 2 Asher

Atlantic etal

Company

FIRST REPORT

Contractor

SECTION PLAT

C W L NE NW

660 Ft. from N. Line Ft. from S. Line990 Ft. from E. Line Ft. from W. Line

HISS POOL

	o		

Location Rig up

Drilling and Remarks:

12" - 200

WOC

RECORD

Cased in., ft.Sand Gas Oil Total Depth

PRODUCTION

1st 24 hrs. Nat. 1st 24 hrs. after shot Gas Cu. Ft.Dry Hole Abandoned

Date

APR 9 1941

19

S. J. LEWIS Scout

Map No. 82 Sec. 31 Twp. 20 R. 13WWell No. 2 AsherAtlantic

Company

COMPLETED

Contractor

SECTION PLAT

C W L NE NW

660 Ft. from N. Line

Ft. from S. Line

990 Ft. from E. Line

Ft. from W. Line

HISS Pool

	0		

Location _____

Rig up _____

Drilling and Remarks:

*Lease 3183**5" C 3252.**5000 acd**Pump 73 P 2 X**356 Gz*

RECORD

Cased _____ in., _____ ft.

Sand _____

Gas _____

Oil _____

Total Depth 3272 1/2

PRODUCTION

1st 24 hrs. Nat. _____

1st 24 hrs. after shot _____

Gas _____ Cu. Ft.

Dry Hole _____

Abandoned _____

Date

S. J. LEWIS

Scout

MAY 7 1941 19