


Map No. _____ Sec. 23 Twp. 23 R. 10 ✓
Well No. 7 Allen Farm _____
Mid-Kansas Company _____

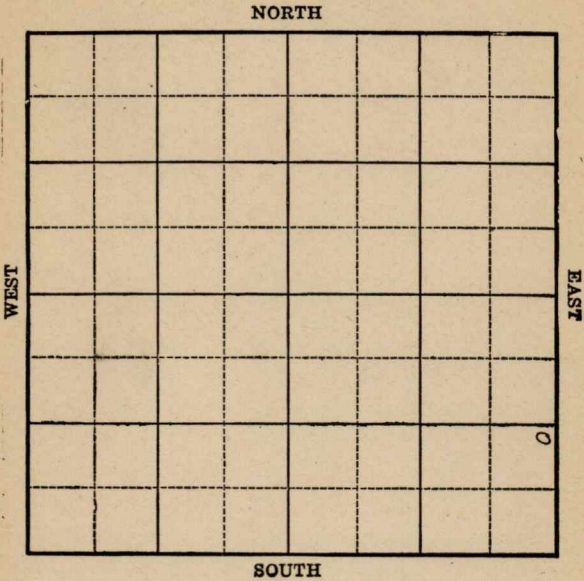

Location _____

Drilling Remarks:

RECORD

Cased _____ in. _____ ft.

Sand _____

Gas _____

Oil _____

Total Depth _____

Rig up _____

Drilling Remarks:

PRODUCTION

1st 24 hrs Nat. _____

1st 24 hrs. after shot _____

Gas _____ cu. ft.

Dry Hole _____


Abandoned _____

Map No. _____ Sec. 23 Twp. 23 R. 10Well No. 7 Allen Farm
Mid-Kansas Company

_____ Ft. from N. Line

990 Ft. from S. Line330 Ft. from E. Line

_____ Ft. from W. Line

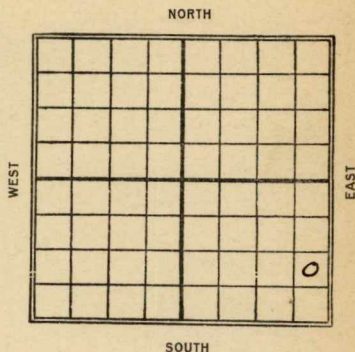

Date

REPORT

19231/125/7Timbers.Sand 2035-2113 - Shot
80 gts. 50 Bbls. J.W. 2160'

Map No. **KANSAS** ¹⁶ Sec. ²³ Twp. ²³ R. ¹⁰Well No. ⁷ *Offen**Mid-Kansas* Company

Contractor

FIRST REPORT

SECTION PLAT

Ft. from N. Line

990 Ft. from S. Line*330* Ft. from E. Line

Ft. from W. Line

Location

Rig up

Drilling and Remarks:

Timbers

RECORD

Cased in. ft.

Sand

Gas

Oil

Total Depth

PRODUCTION

1st 24 hrs. Nat.

1st 24 hrs. after shot

Gas Cu. Ft.

Dry Hole

Abandoned

Date JAN 12 1923

Maps show #3
 here. What is
 correction location?

SECTION PLAT

_____ Ft. from N. line
 _____ Ft. from S. line
 _____ Ft. from E. line
 _____ Ft. from W. line

RECORD

_____ in _____ Cased
 _____ Sand
 _____ Gas

PRODUCTION

_____ 24 hrs. after shot
 _____ 24 hrs. after shot
 _____ 24 hrs. after shot

Returned	<i>[Signature]</i>
Cards	<i>[Signature]</i>
Tracing	
J. S. C. map	
Frantz map	<i>[Signature]</i>
Moody map	
Frantz plat book	
Moody plat book	

Map No. 16 Sec. 23 Twp. 23 R. 10

Well No. 7 Allen
Mid-Kansas Company

Contractor

COMPLETED

SECTION PLAT

COMPLETED

Ft. from N. Line

990 Ft. from S. Line

330 Ft. from E. Line

Ft. from W. Line

RECORD

Location

Rig up

Drilling and Remarks:

sand { 2035
2113
70.2140
80/50 of flk

Cased 16 m. ft.

Sand

Gas

Oil

Total Depth

PRODUCTION

1st 24 hrs. Nat.

1st 24 hrs. after shot

Gas Cu. Ft.

Dry Hole

Abandoned

Date

MAY 7 1923

M. A. BENEAR

191

Scout

Over

Maps shown #3
mod. well here.
What is correct?

All of these
locations are
990 X 330
excepting
those on
the South
line

Returned	<i>WMS</i>
Cards	<i>WMS</i>
Tracing	<i>P</i>
J. S. C. map	<i>P</i>
Frantz map	<i>WMS</i>
Moody map	
Frantz plat book	
Moody plat book	