


Map No. _____ Sec. 23 Twp. 23 R. 10
Well No. 8 Allen Farm _____
Mid-Kansas Company _____

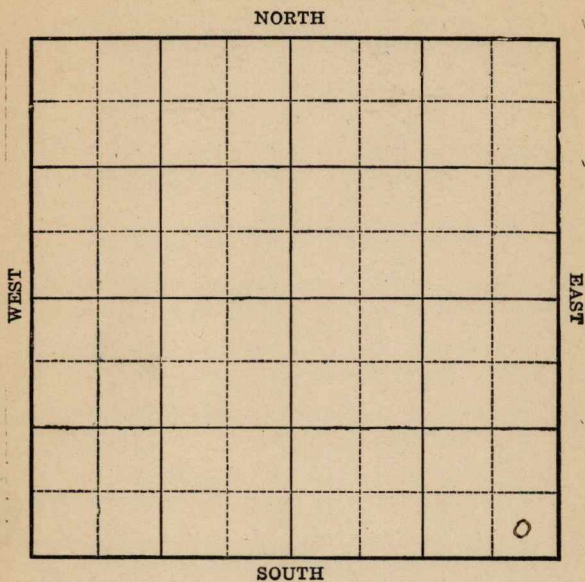

Location _____

Drilling Remarks:

RECORD

Cased _____ in. _____ ft.

Sand _____

Gas _____

Oil _____

Total Depth _____

Rig up _____

Drilling Remarks:

PRODUCTION

1st 24 hrs Nat. _____

1st 24 hrs. after shot _____

Gas _____ cu. ft.

Dry Hole _____

Abandoned _____

Map No. _____ Sec. 23 Twp. 23 R. 10

Well No. 8 Allen Farm
Mid-Kansas Company

NORTH

Ft. from N, Line

330 Ft. from S. Line

330 Ft. from E. Line

Ft. from W. Line



SOUTH

Date _____

REPORT

(923

 $\frac{1}{12}$

Timbers

3/22

Abandoned location:

Map No. **KANSAS** 16 23 Sec. 23 Twp. 23 R. 10

Well No. 8 - Aflin
Mid-Kansas Company

Contractor

FIRST REPORT

SECTION PLAT

-----Ft. from N. Line
330 Ft. from S. Line
330 Ft. from E. Line
-----Ft. from W. Line

			0

Location -----
Rig up -----
Drilling and Remarks:

Timber

RECORD

Cased ----- in., ----- ft.
Sand -----
Gas -----
Oil -----
Total Depth -----

PRODUCTION

1st 24 hrs. Nat. -----
1st 24 hrs. after shot -----
Gas ----- Cu. Ft.
Dry Hole -----
Abandoned -----

Date JAN 12 1923

Map No. **KANSAS** *16* Sec. *23* Twp. *23* R. *10*Well No. *8 Allen**Mid-Kansas* Company

Contractor

ABANDONED

SECTION PLAT

			0

Ft. from N. Line

330 Ft. from S. Line*330* Ft. from E. Line

Ft. from W. Line

Location

Rig up

Drilling and Remarks:

Location
Abandoned

RECORD

Cased _____ in., _____ ft.

Sand _____

Gas _____

Oil _____

Total Depth _____

PRODUCTION

1st 24 hrs. Nat. _____

1st 24 hrs. after shot _____

Gas _____ Cu. Ft.

Dry Hole _____

Abandoned _____

Date

M. A. BENEAR**MAR 22 1923**

192

Scout