

Map No. _____ Sec. 23 Twp. 23 R. 10

Well No. 9 Allen Farm

Mid-Kansas Company

NORTH

WEST

EAST

SOUTH

Location _____

Drilling Remarks:

Rig up _____

Drilling Remarks:

RECORD

Cased _____ in. _____ ft.

Sand _____

Gas _____

Oil _____

Total Depth_____

PRODUCTION

1st 24 hrs Nat. _____

1st 24 hrs. after shot_____

Gas _____ cu. ft.

Dry Hole _____

Abandoned _____

Map No. _____ Sec. 23 Twp. 23 R. 10


Well No. 9 Allen Farm
Mid-Kansas Company

330 Ft. from N, Line

_____Ft. from S. Line

330 Ft. from E. Line

Ft. from W. Line

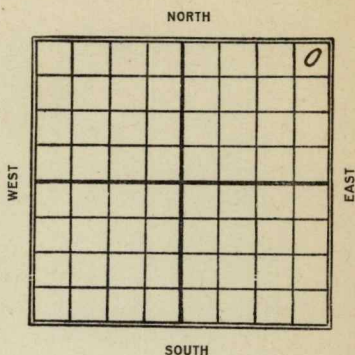

Date
1923

REPORT

3/2	Rig
6/10	Sand 2088-2108 - shot 800 ft. 110 BBL.

Map No. KANSAS 16 Sec. 23 Twp. 23 R. 10
 Well No. 9 Allen
Mid-Kansas Company
 Contractor

FIRST REPORT

SECTION PLAT

			0

330 Ft. from N. Line
 _____ Ft. from S. Line
330 Ft. from E. Line
 _____ Ft. from W. Line

Location _____
 Rig up ✓✓
 Drilling and Remarks:

RECORD

Cased _____ in., _____ ft.
 Sand _____
 Gas _____
 Oil _____
 Total Depth _____

PRODUCTION

1st 24 hrs. Nat. _____
 1st 24 hrs. after shot _____
 Gas _____ Cu. Ft.
 Dry Hole _____
 Abandoned _____

Date MAR 2 1923 M. A. BENEAR
 _____ 191 _____ Scout

Map No. **KANSAS** *16* Sec. *23* Twp. *23* R. *10*Well No. *9 Allen**Mid-Kansas* Company

Contractor

COMPLETED SECTION PLAT*330* Ft. from N. Line

Ft. from S. Line

330 Ft. from E. Line

Ft. from W. Line

			<i>0</i>

Location

Rig up

Drilling and Remarks:

sand { 2088
*12108**80/110 bbls.***RECORD**

Cased _____ in., _____ ft.

Sand _____

Gas _____

Oil _____

Total Depth _____

PRODUCTION

1st 24 hrs. Nat. _____

1st 24 hrs. after shot _____

Gas _____ Cu. Ft.

Dry Hole _____

Abandoned _____

Date

M. A. BENEAR**JUN 10 1923**

_____ 192 _____ Scout