

Sedgwick
 Map No. KANSAS Sec. 22 Twp. 28 R. 1E
 Well No. 1- Stucky Farm
Melmac Oil Company

NORTH

WEST

0							

EAST

SOUTH

Location.....

Drilling Remarks

Rig Up.....

Drilling Remarks

RECORD

Used..... in..... ft.

Sand.....

Gas.....

Oil.....

Total Depth.....

PRODUCTION

1st 24 hrs. Nat.....

1st 24 hrs. after shot.....

Gas..... cu. ft.

Dry Hole.....

Abandoned.....


Sedgwick
 Map No. KANSAS Sec. 22 Twp. 28 R. 1E
 Well No. 1- Stuckey Farm
Wilmac Oil Corp Company

330 Ft. from N. Line

_____ Ft. from S. Line

_____ Ft. from E. Line

330 Ft. from W. Line

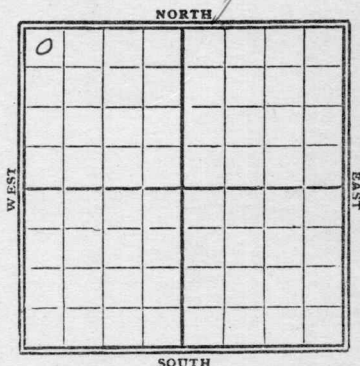

1929

Date

REPORT

5/29	Cellar
6/5	Rig
6/12	
6/19	—
6/26	Rig up
7/2	dry 350'
7/10	" 1040'
7/17	" 1640'
7/24	" 2060'
7/31	W.R. 8" - 2630'
8/7	set 8" - 2666'
	dry 2698'
8/14	" 2880'
8/21	Top Miss L. 3081 - dry 3140'
8/28	dry 3200'
9/4	" 3305'
9/11	gas sand 3492'
	water 3504-17'
	dry 3524'
9/18	show oil 3483'
	HFW 3504-17'
	T.D. 3520' Abandon

Map No. KANSAS Sec. 22 Twp. 28 R. 1E

Well No. 18 Truck

Wilma Oil Corp. Company

Contractor

SECTION PLAT

330 Ft. from N. Line

_____ Ft. from S. Line

_____ Ft. from E. Line

330 Ft. from W. Line

0			

FIRST REPORTS

Location _____

Rig up _____

Drilling and Remarks:

O & H

RECORD

Cased _____ in., _____ ft.

Sand _____

Gas _____

Oil _____

Total Depth _____

PRODUCTION

1st 24 hrs. Nat. _____

1st 24 hrs. after shot _____

Gas _____ Cu. Ft.

Dry Hole _____

Abandoned _____

Date

MAY 29 1929

192

J. LEWIS

Scout

Seelgwick
 Map No. KANSAS Sec. 22 Twp. 28 R. 11

Well No. 1 Stucky

Milmac Oil Corp. Company

Contractor

SECTION PLAT

330 Ft. from N. Line

..... Ft. from S. Line

..... Ft. from E. Line

330 Ft. from W. Line

0			

ABANDONED

Location.....

Rig up.....

Drilling and Remarks:

Show oil 3483

NFW 3504-17

RECORD

Cased.....in.,ft.

Sand.....

Gas.....

Oil.....

Total Depth 3520

PRODUCTION

1st 24 hrs. Nat.....

1st 24 hrs. after shot.....

Gas.....Cu. Ft.

Dry Hole.....

Abandoned.....

Date

SEP 18 1922

S. J. LEWIS

Scout