Sec. 23 Twp. 23 Range 10E

#13 Allen

Kansas Geological Society

Mid-Kansas


Skelly Scout Tickets

Form 252A 8M-11-20 PALACE-TULSA 4617

Map No. Sec. 23 Twp. 23 R. 10

Well No. 13 Allen Farm

Mid-Kansas Company

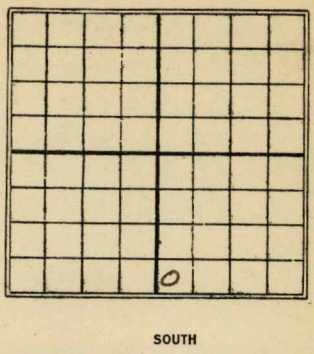

Ft. from N. Line

330 Ft. from S. Line

Ft. from E. Line

330 Ft. from W. Line

Date 1923	REPORT
3/2	Rig.
6/23	Sand 2138-2205 - Shot 100 qts. 100 Bbls.

Form 26—1M—4-19—Mid-West

Map No. KANSAS 16 Sec. 23 Twp. 23 R. 10


Well No. 13, Allen

Mid-Kansas Company

Contractor

FIRST REPORT

SECTION PLAT

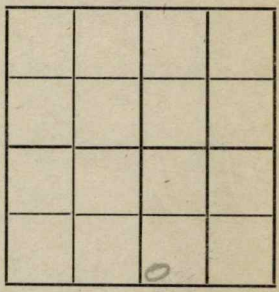

330 Ft. from N. Line

Ft. from S. Line

Ft. from E. Line

330 Ft. from W. Line

Location

Rig up

Drilling and Remarks:

RECORD

Cased in., ft.

Sand

Gas

Oil

Total Depth

PRODUCTION

1st 24 hrs. Nat.

1st 24 hrs. after shot

Gas Cu. Ft.

Dry Hole

Abandoned

Date

MAR 2 1923

191

M. A. BENEAR

Scout

Form 26—1M Bks.—3-23—11959.


Map No. KANSAS 16 Sec. 23 Twp. 23 R. 10

Well No. 13 - Allen

Mid-Kansas Company

Contractor

COMPLETED SECTION PLAT

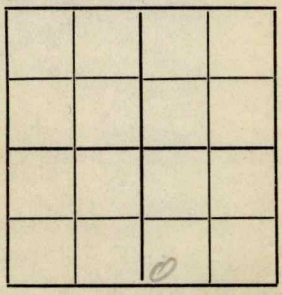

_____Ft. from N. Line

330 Ft. from S. Line

_____Ft. from E. Line

330 Ft. from W. Line

Location _____

Rig up _____

Drilling and Remarks:

sand 2138
2205
100/10

RECORD

Cased _____ in., _____ ft.

Sand _____

Gas _____

Oil _____

Total Depth _____

PRODUCTION

1st 24 hrs. Nat. _____

1st 24 hrs. after shot _____

Gas _____ Cu. Ft.

Dry Hole _____

Abandoned _____

Date

JUN 23 1923

_____ 192___.

M. A. BENEAR

_____ Scout