
Form 51—5M—7-25—19786

Kansas Greenwood

Map No. Sec. 23 Twp. 22 R. 10

Well No. 15 Allen Farm

Mid-Kansas Company

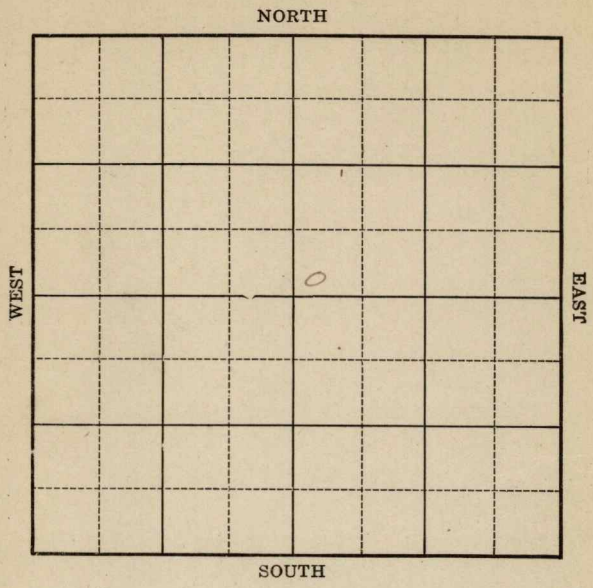

Location

Drilling Remarks

Rig Up

Drilling Remarks

RECORD

Cased in. ft.

Sand

Gas

Oil

Total Depth

PRODUCTION

1st 24 hrs. Nat.

1st 24 hrs. after shot

Gas cu. ft.

Dry Hole

Abandoned


Form 252A—5M—7-25—19684

Greenwood

Map No. KANSAS Sec. 23 Twp. 23 R 10

Well No. 15 Allen Farm

Mid-Kansas Company

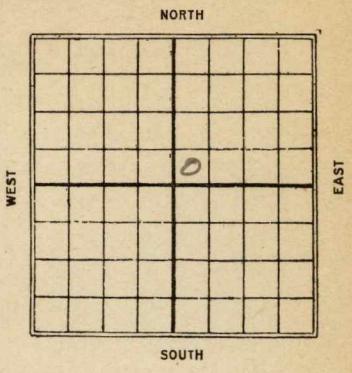

____ Ft. from N. Line

330 Ft. from S. Line

____ Ft. from E. Line

330 Ft. from W. Line

1926

Date	REPORT
2/10	Bldg Rig
2/17	Drlg 25 ft.
2/24	" 600'
3/5	" 1100
3/10	" 2000
3/18	Btm Sand 2042-98
	Sand 2098-2113
	T.D. 2116 P.B. 2113
	100 gts 25 bbls

Form 26—1M Bks.—3-23—11959.

Sherwood Co.

1416 KANSAS

Map No. _____ Sec. 23 Twp. 22 R. 10


Well No. 15 Wilson

Mid-Kansas

_____ Company

_____ Contractor

SECTION PLAT

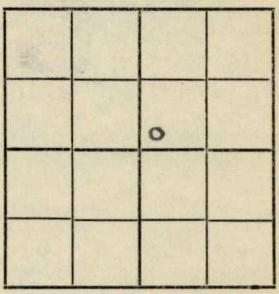

330 Ft. from N. Line

330 Ft. from S. Line

_____ Ft. from E. Line

_____ Ft. from W. Line

FIRST REPORTS

Location _____

Rig up _____

Drilling and Remarks:

Blog Rig

RECORD

Cased _____ in., _____ ft.

Sand _____

Gas _____

Oil _____

Total Depth _____

PRODUCTION

1st 24 hrs. Nat. _____

1st 24 hrs. after shot _____

Gas _____ Cu. Ft.

Dry Hole _____

Abandoned _____

Date

FEB 10 1926

192____

CHAS. L. SHERWOOD

_____ Scout

Form 26—1M Bks.—3-23—11959. Sherwood

1616 Map No. KANSAS Sec. 23 Twp. 22 R. 10

Well No. 15 Allen

Mid-Kansas Company

Contractor

COMPLETED


Ft. from N. Line

330 Ft. from S. Line

Ft. from E. Line

330 Ft. from W. Line

SECTION PLAT

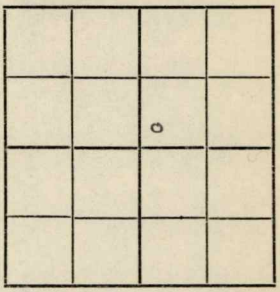

Location

Rig up

Drilling and Remarks:

Broke Sand 2042-98

Sand 2098-2113'

TD 2116' Plugged back

To 2113'

10 by 25 Bbl.

RECORD

Cased in., ft.

Sand

Gas

Oil

Total Depth 2116'

PRODUCTION

1st 24 hrs. Nat.

1st 24 hrs. after shot

Gas Cu. Ft.

Dry Hole

Abandoned

Date

MAR 18 1926 192

CHAS. L. SHERWOOD Scout