
Form 51 SM 11-23 13896

Map No. K Sec. 23 Twp. 23 R. 10

Well No. 17 Allen Farm

Mid-Kansas Company

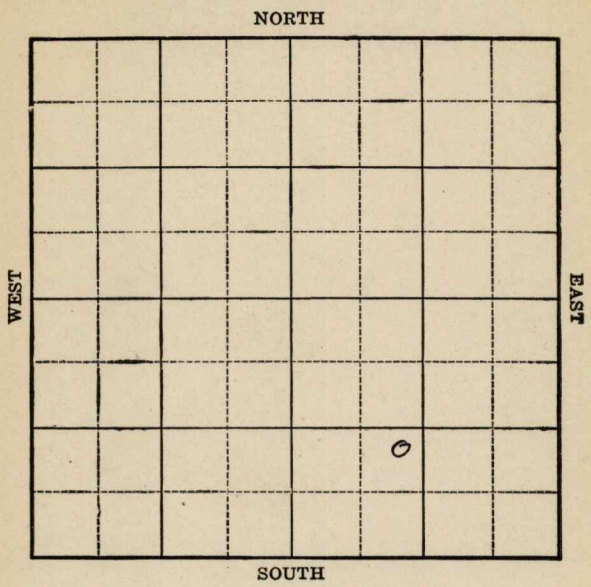

Location _____

Drilling Remarks:

Rig Up _____

Drilling Remarks:

RECORD

Cased _____ in. _____ ft.

Sand _____

Gas _____

Oil _____

Total Depth _____

PRODUCTION

1st 24 hrs. Nat. _____

1st 24 hrs. after shot _____

Gas _____ cu. ft.

Dry Hole _____

Abandoned _____

Form 252A 5M 4-22 8765

Map No. K Sec. 23 Twp. 22 R. 10

Well No. 17 Allen Farm


Mid-Kansas Company

____ Ft. from N. Line

990 Ft. from S. Line

____ Ft. from E. Line

990 Ft. from W. Line

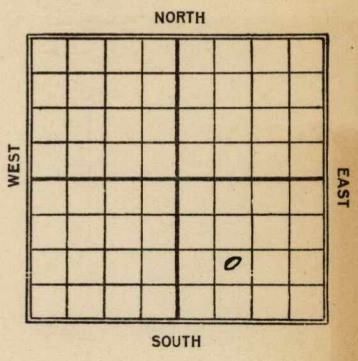

Date	REPORT
1/24	
3/27	Timbers
4/2	Ivy sand 2036
	H. O. 2046 - 2105
	T.D. 2105 -
	140/100 Bbls

Form 26—1M Bks.—3-23—11959.

Map No. KANSAS 16 Sec. 23 Twp. 23 R. 10


Well No. 17 - A Allen

Mid-Kans Company

Contractor

FIRST REPORT

SECTION PLAT

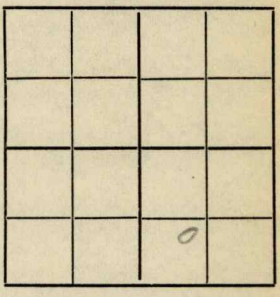

990 Ft. from N. Line

Ft. from S. Line

Ft. from E. Line

990 Ft. from W. Line

Location

Rig up

Drilling and Remarks:

Timbers

RECORD

Cased in., ft.

Sand

Gas

Oil

Total Depth

PRODUCTION

1st 24 hrs. Nat.

1st 24 hrs. after shot

Gas Cu. Ft.

Dry Hole

Abandoned

Date

FEB 27 1924

192

M. A. BENEAR Scout

Form 32 S.C.O.P.Co. 500 Bks. 5-23 12529


KANSAS

Map No. ____ Sec. 33 Twp. 33 R. 10

Well No. #17 Allen Farm

Mid-Kansas Company

990 from S NORTH 990 from W

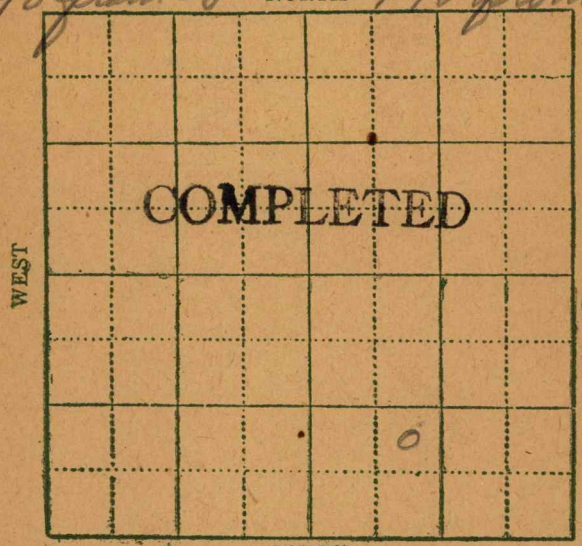

Location _____

Rig up _____

Drilling and Remarks:

Lap s. 2036

T.D. 2046-2105

T.D. 2108

140/100

RECORD

Cased _____ in., _____ ft.

Sand _____

Gas _____

Oil _____

Total Depth _____

PRODUCTION

1st 24 hrs. Nat. _____

1st 24 hrs. after shot _____

Gas _____ Cu. Ft.

Dry Hole _____

Abandoned _____

Date APR 2 1924 192____

M. A. BENEAR Scout