

WEST

EAST

SOUTH

Rig Up _____ Drilling Remarks

Total Depth-----

PRODUCTION


Abandoned-----

Map No. KANSAS Sec. 27 Twp. 28 R. 1EWell No. 1- Russell Farm
Claddin Fisher & Land Company

Ft. from N. Line

660 Ft. from S. Line735 Ft. from E. Line1930 Ft. from W. Line

NORTH

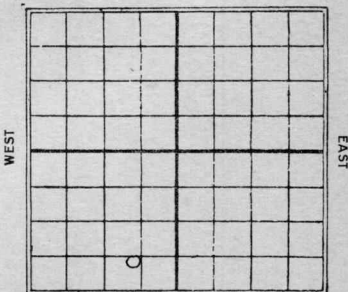

SOUTH

Date

REPORT

Date	REPORT
9/17	Log
9/24	Log
10/1	Spud
10/8	Drly 375'
10/15	" 1430'
10/22	" 2185'
10/29	" 2815'
11/5	2 1/2" 2845'
11/12	Run 6" - 3160'
11/19	Top Miss 3206'
	Drly 3210'
11/20	Top Chat 3295'
	Drly 3485'
12/2	Base Miss 3460'
	Helcox 3582-3608'
	T.D. 3608' HFW
	Dry & Abandon

Georgewick
 Map No. KANSAS Sec. 27 Twp. 28 R. 1E

Well No. 1 Russell

Gladden & Fisher-Lanck Company

Contractor

SECTION PLAT

_____ Ft. from N. Line

660 Ft. from S. Line

725 Ft. from E. Line

_____ Ft. from W. Line

FIRST REPORTS

Location _____

Rig up _____

Drilling and Remarks:

ROG

RECORD

Cased _____ in., _____ ft.

Sand _____

Gas _____

Oil _____

Total Depth _____

PRODUCTION

1st 24 hrs. Nat. _____

1st 24 hrs. after shot _____

Gas _____ Cu. Ft.

Dry Hole _____

Abandoned _____

Date

SEP 17 1930

19

S. J. LEWIS Scout


Map No. 120 KANSAS Sec. 27 Twp. 28 R. 15

Well No. 1 Russell

Cladden-Fisher & Lanch Company

Contractor

SECTION PLAT

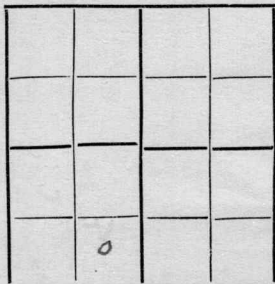

Ft. from N. Line

660 Ft. from S. Line

735 Ft. from E. Line

Ft. from W. Line

ABANDONED

Location

Rig up

Drilling and Remarks:

Base Mass 3460
W. Log 3582-3608
NFV

RECORD

Cased in., ft.

Sand

Gas

Oil

Total Depth 2608

PRODUCTION

1st 24 hrs. Nat.

1st 24 hrs. after shot

Gas Cu. Ft.

Dry Hole

Abandoned

Date

DEC 3 1930

S. J. LEWIS

Scout